


T.18S.R.3W.W.M.

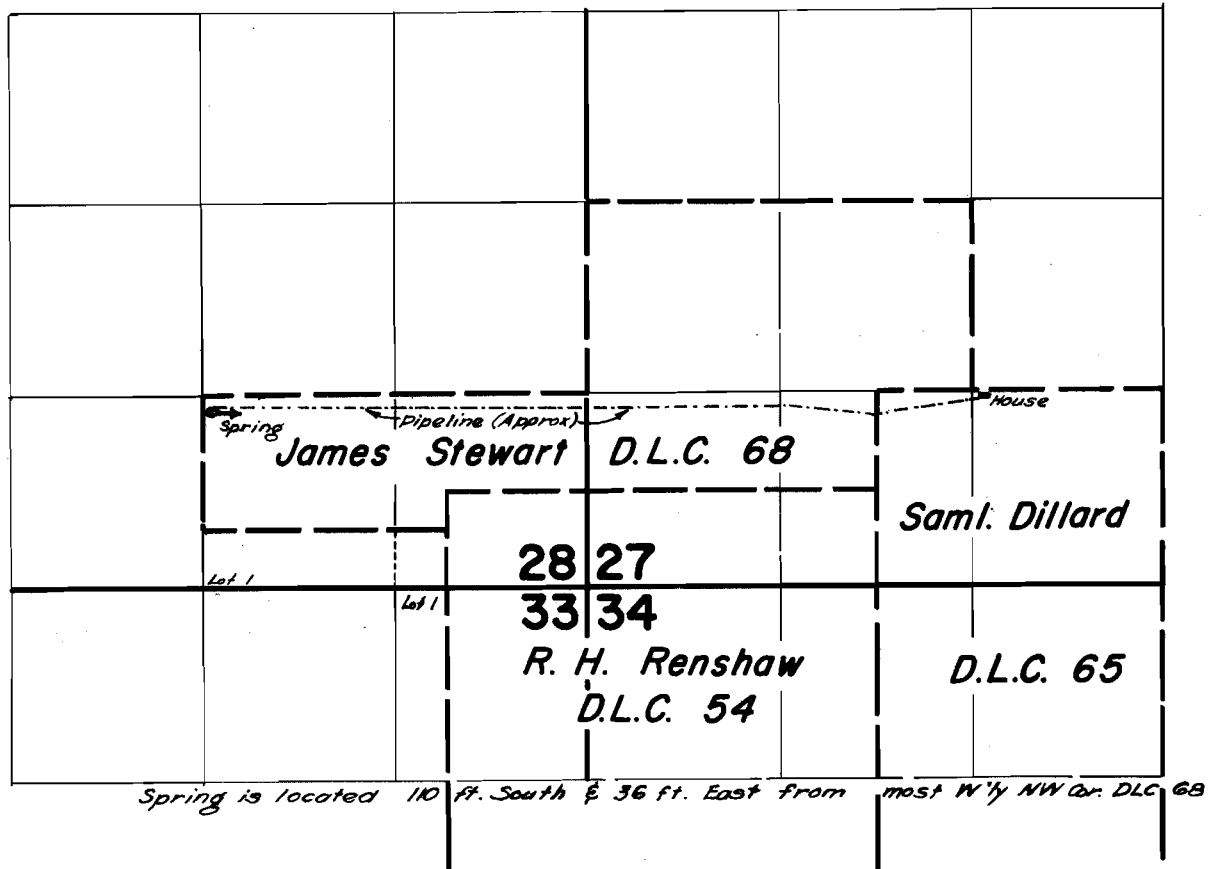

FINAL PROOF SURVEY
UNDER

Application No. 40393 Permit No. 30111
IN NAME OF

ALMA I. & ETHEL WEBB

