


T.14S.R.12W.W.M.

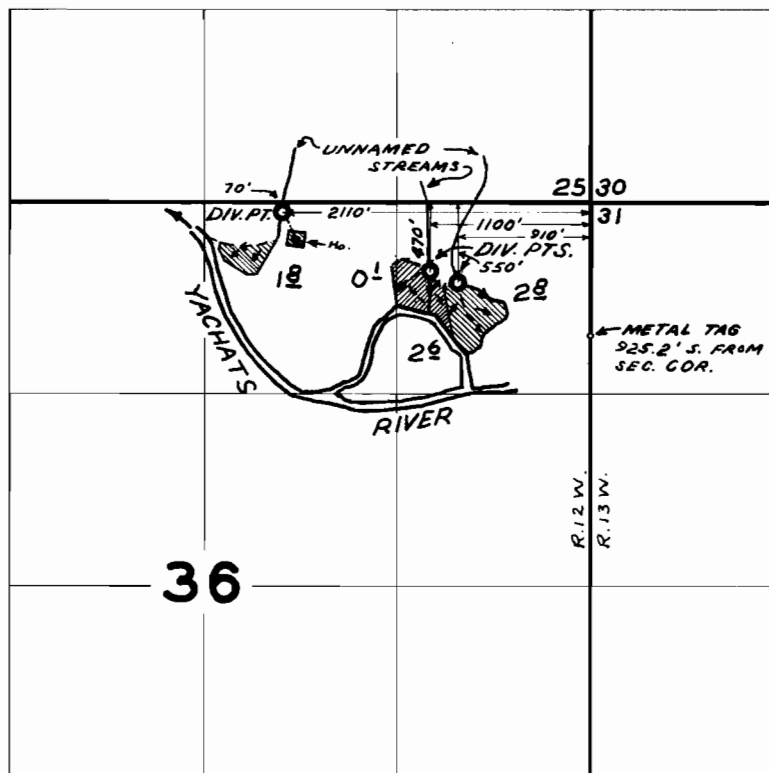

FINAL PROOF SURVEY
UNDER

Application No. 41594 Permit No. 31023
IN NAME OF

LEONARD CARSON

Surveyed AUG. 22 1966, by L. GOULD