


T.13S.R.10W.W.M.

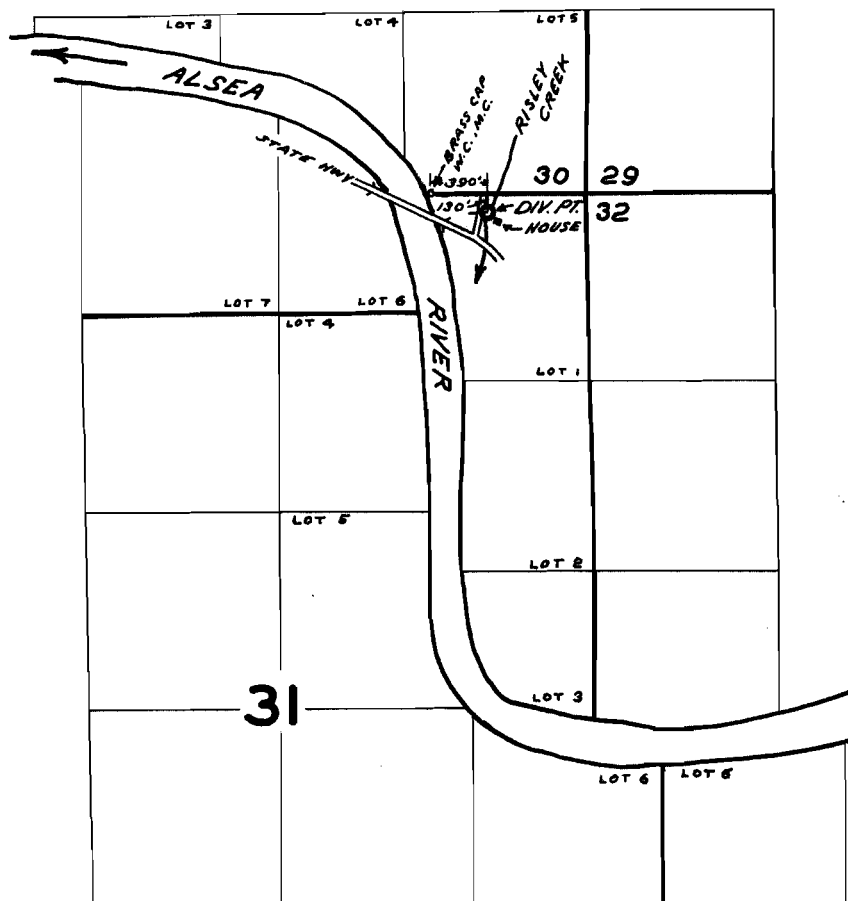

FINAL PROOF SURVEY
UNDER

Application No. 40581 Permit No. 30236
IN NAME OF

LEONA Q. FRITCH

Surveyed AUG. 23 1966, by L. GOULD