


T.13S.R.11&12W.W.M.

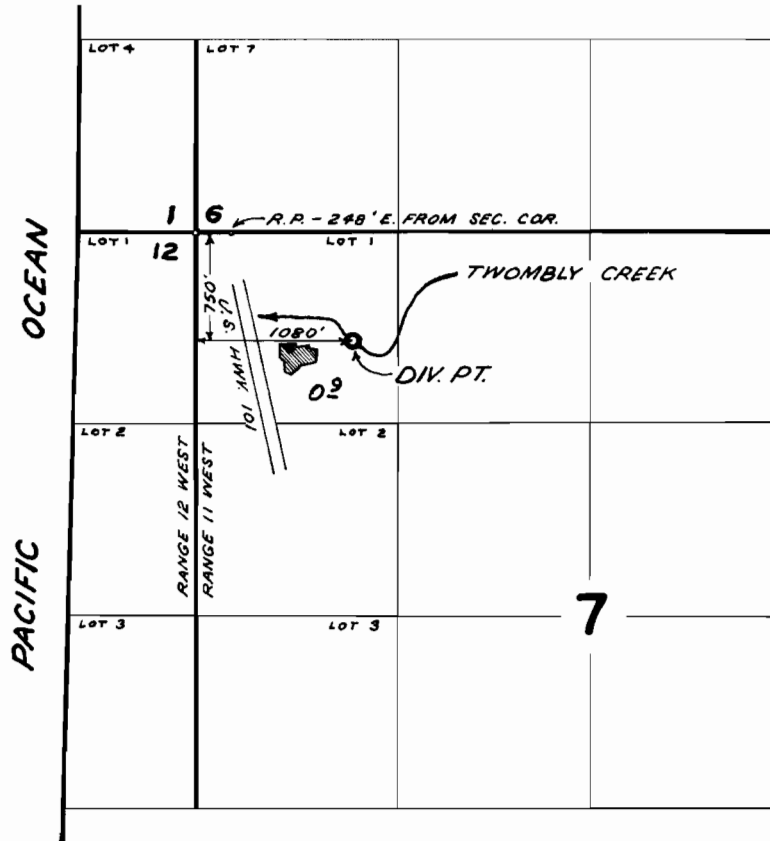

FINAL PROOF SURVEY

UNDER

Application No. 41647 Permit No. 31082
IN NAME OF

FLORENCE I. HALLOWELL

Surveyed AUG. 25 1966, by L. GOULD