


T.13S.R.10W.W.M.

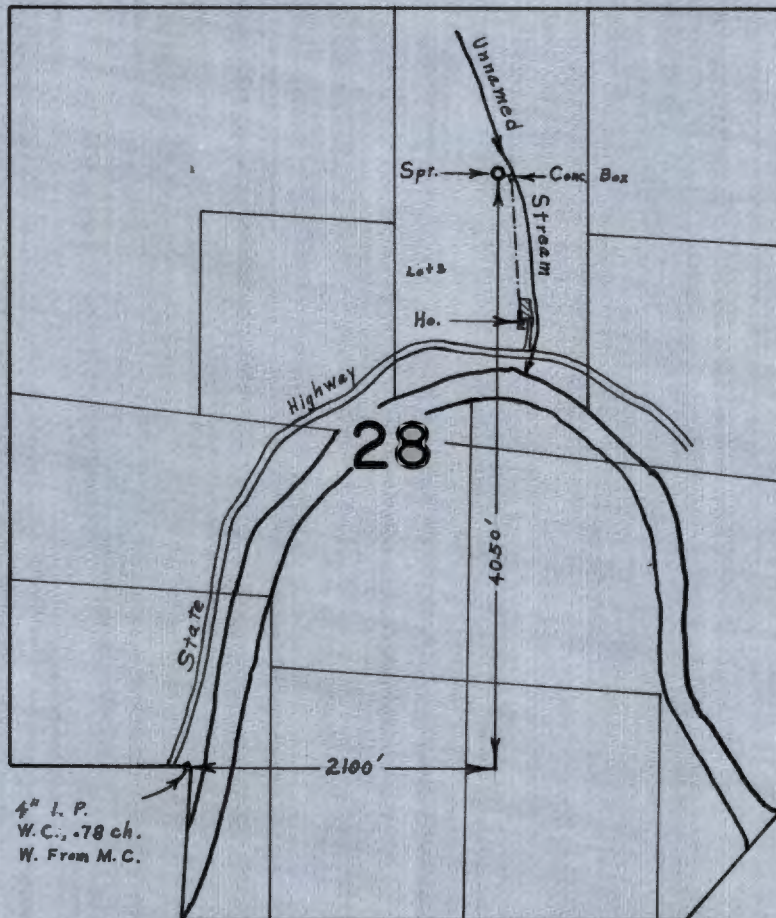

FINAL PROOF SURVEY
UNDER

Application No. 39911 Permit No. 29706
IN NAME OF
PURNELL TIBBETTS

Surveyed Aug 24 1966, by L. E. Gould