


T. 14 S. R. 1 W. W. M.

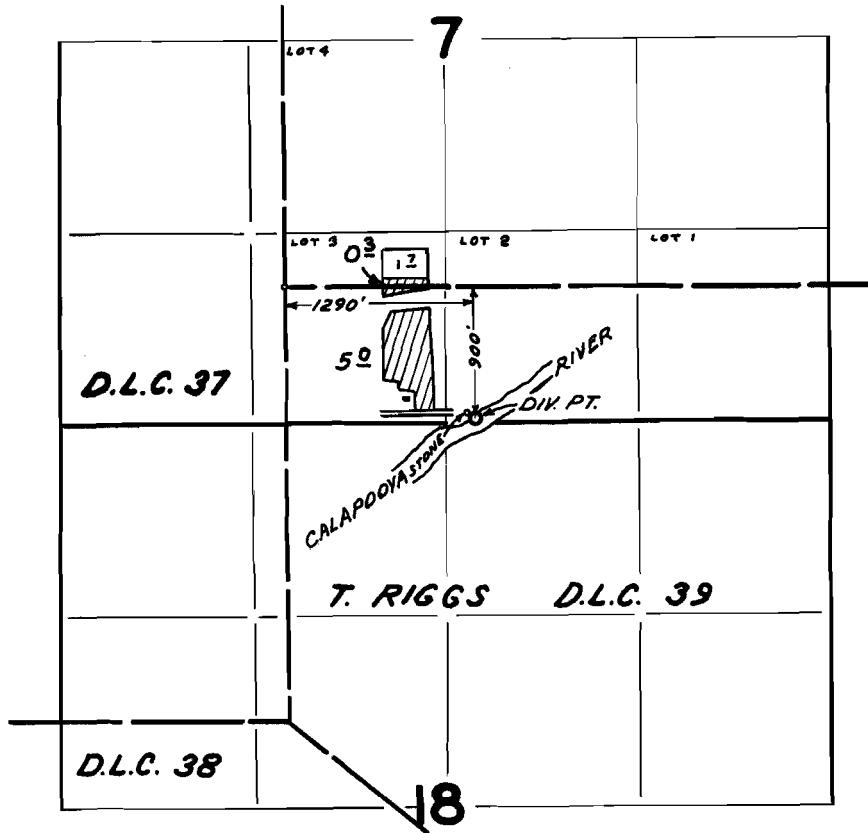

FINAL PROOF SURVEY UNDER

Application No. 40567 Permit No. 30227
IN NAME OF

DONALD A. CHRISTENSEN

Surveyed OCT 14, 1965, by R. JACKSON