


# T. 13 & 14 S. R. 2 W. W.M.

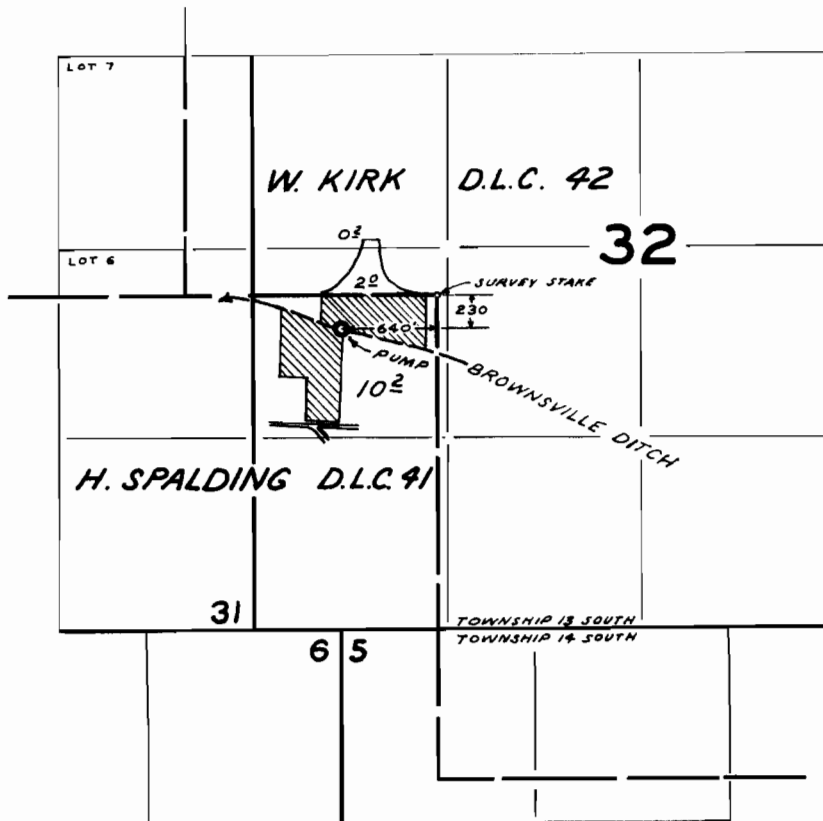

## FINAL PROOF SURVEY UNDER

Application No. 38975 Permit No. 28982  
IN NAME OF  
**T. J. HOWARD**

Surveyed SEP. 20 1965, by R. JACKSON