


T.6S.R.2W.W.M.

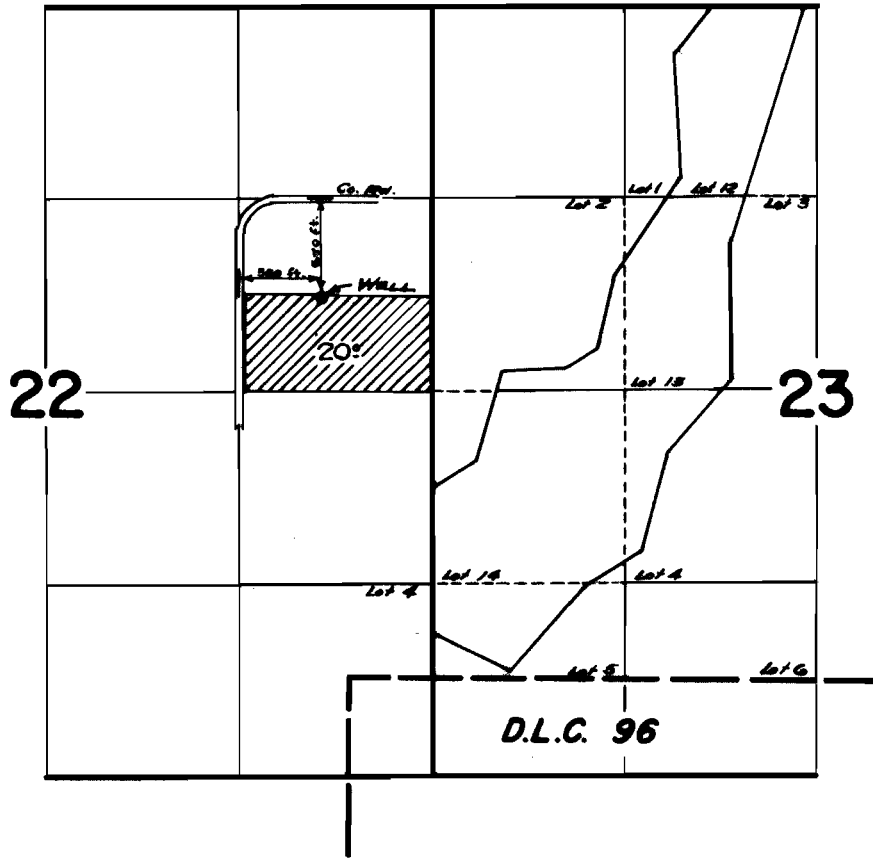

FINAL PROOF SURVEY UNDER

Application No. G-2287. Permit No. G-2112.
IN NAME OF

VELMA DOERFLER

Surveyed June 15 1965, by *R. Jackson*