


T.3S.R.2W.W.M.

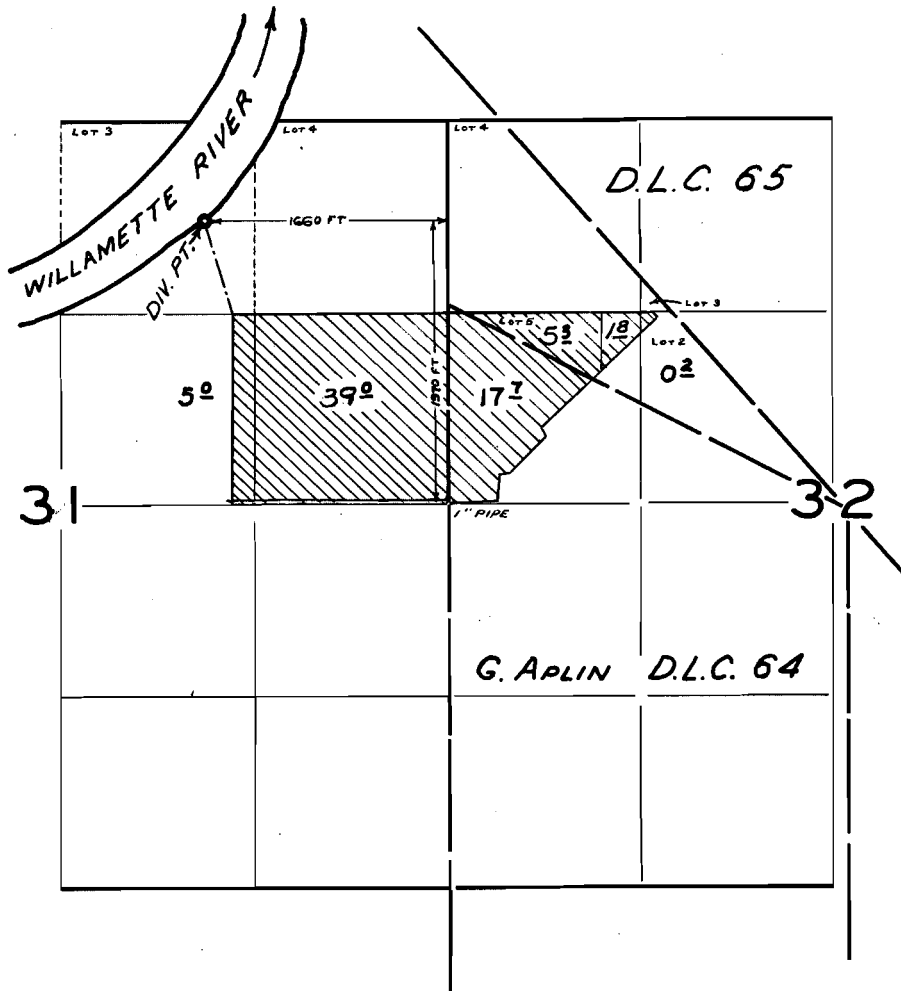

FINAL PROOF SURVEY
UNDER

Application No. 40119 Permit No. 29980

IN NAME OF

FRED B. HILLER

Surveyed APR. 23 1965, by C. GARDNER