


T.4S.R.2W.W.M.

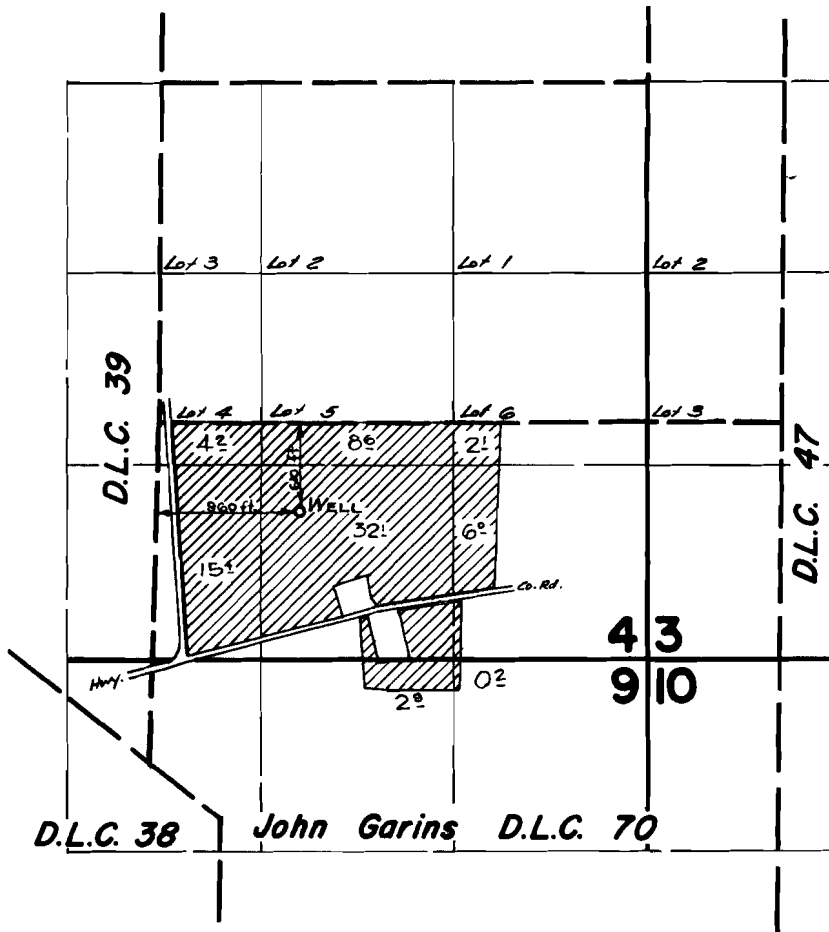

FINAL PROOF SURVEY UNDER

Application No. G-2842 Permit No. G-2649
IN NAME OF

MICHAEL E. HOPFER

Surveyed June 2, 1965, by [Signature]