


T.7&8S. R.I.E.W.M.

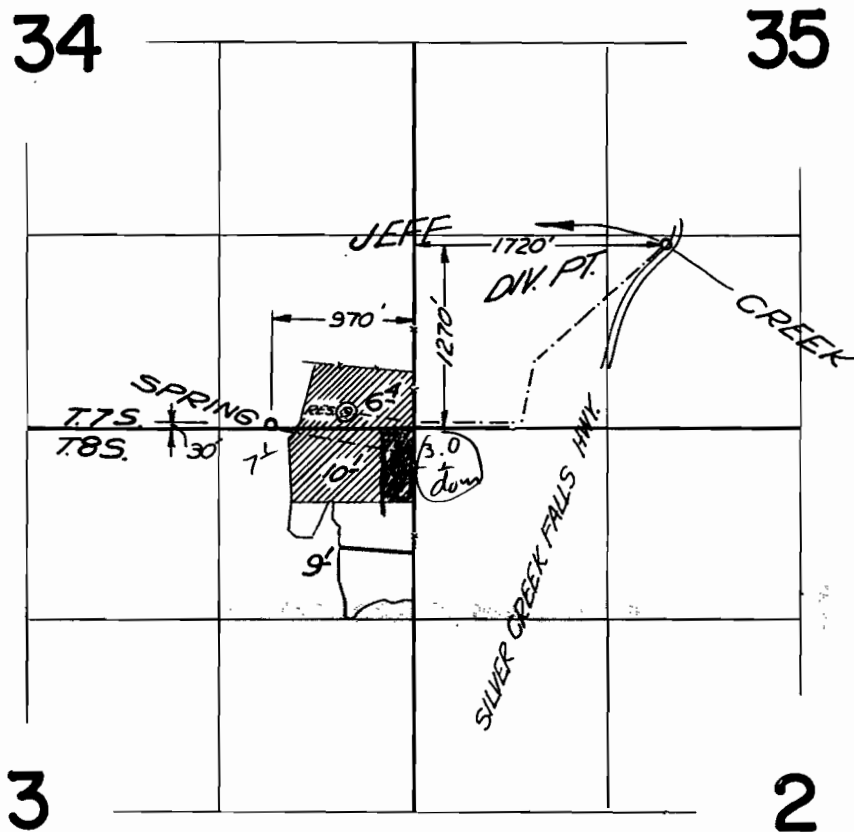

FINAL PROOF SURVEY UNDER

Application No. 37213 Permit No. 27924
IN NAME OF

RALPH A. JACK and MARIAN B. JACK

Surveyed Aug. 19, 1966, by V. GARNER.