


T.4S.R.2W.W.M.

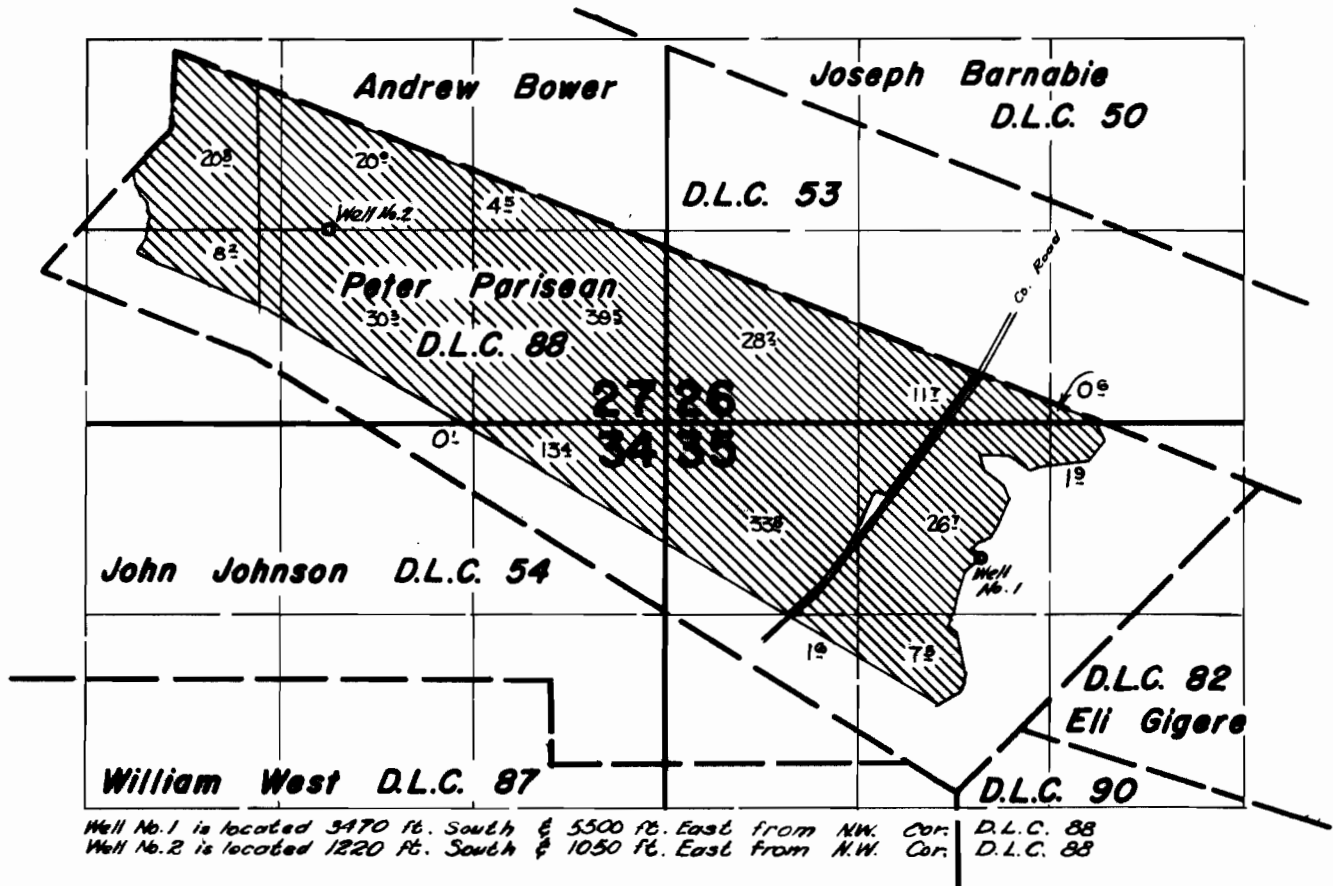

FINAL PROOF SURVEY UNDER

Application No. **G-2201** Permit No. **G-2033**
 IN NAME OF

NEAL W. MILLER

Surveyed *June 16* 1965, by *R. Jackson*