


T.8S.R.3W.W.M.

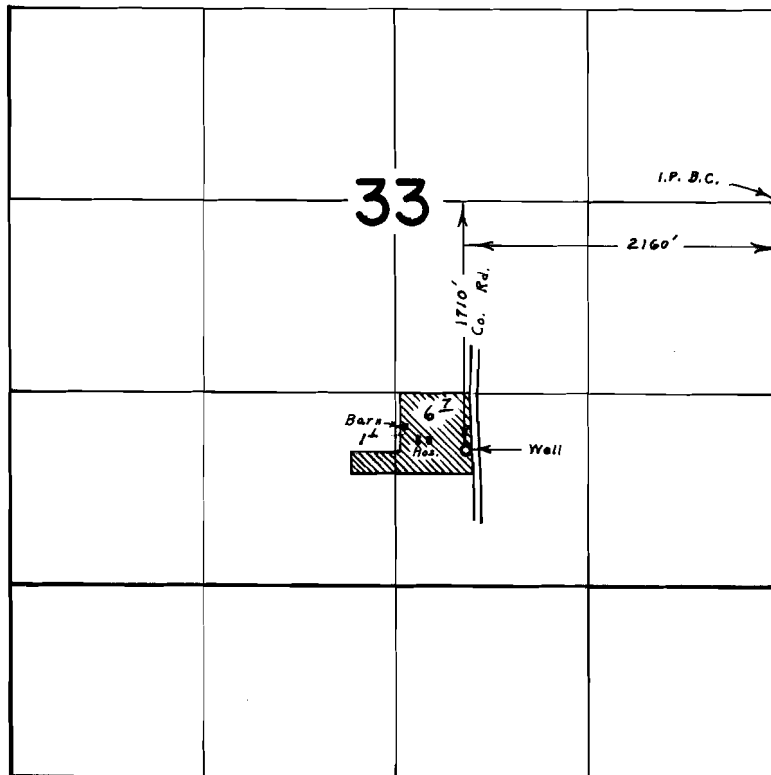

FINAL PROOF SURVEY
UNDER

Application No. G-2064 Permit No. G-1902
IN NAME OF
VALL C. PRIEST

Surveyed Sept. 9, 1966, by L. E. Gould
Mar. 31 1967