


7  
G-681  
34196

1966-T-0468

T.1N.R.27&28E.W.M.

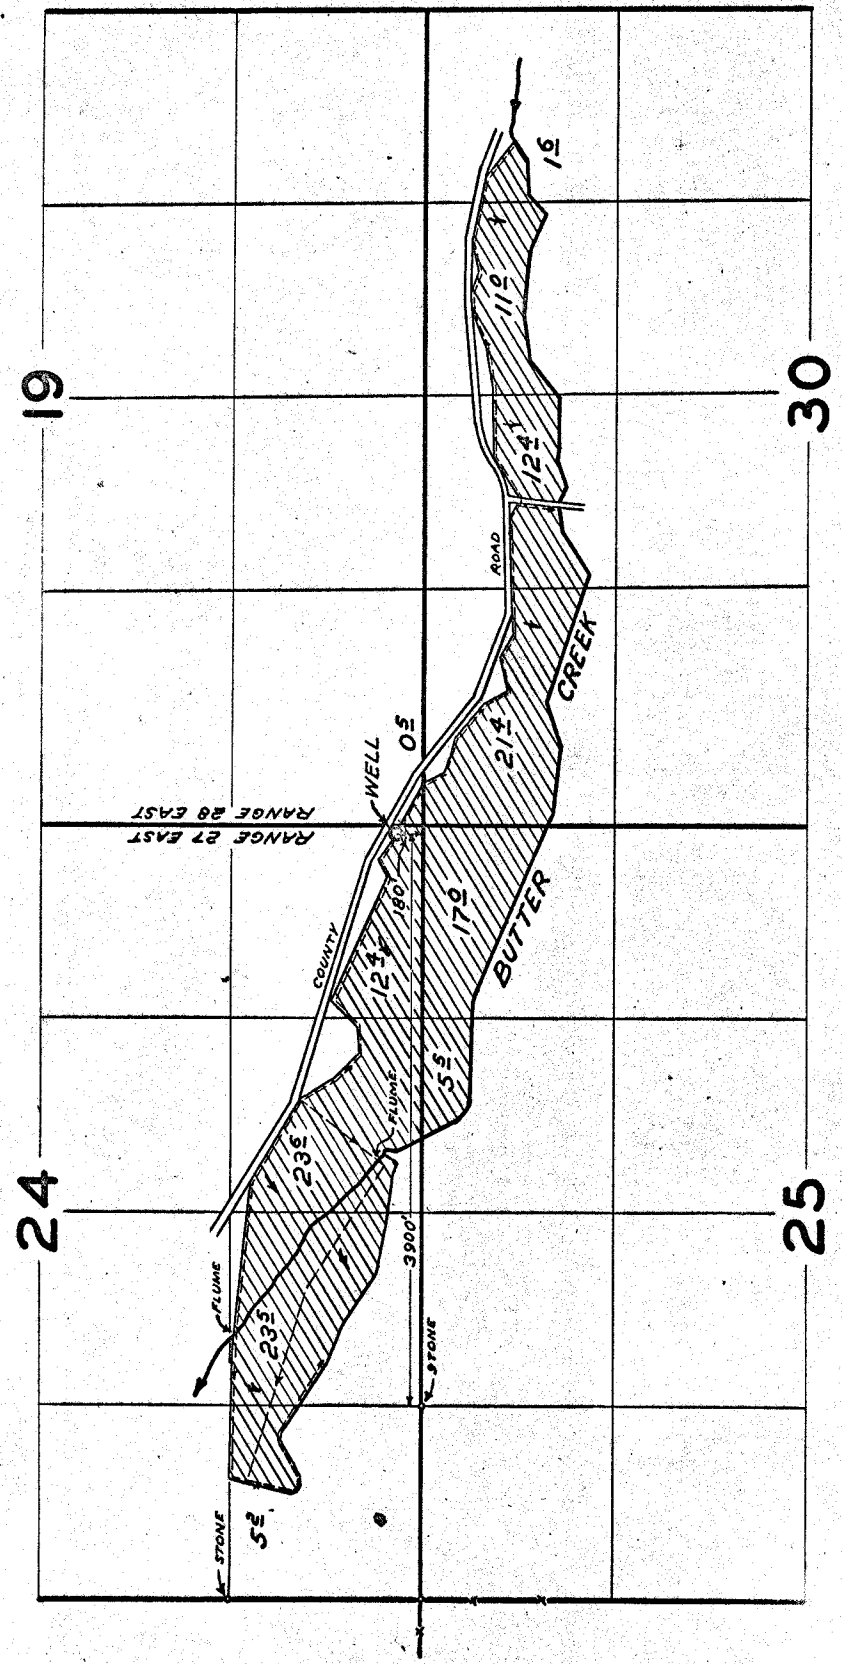

# FINAL PROOF SURVEY UNDER

APPLICATION NO. G-784, PERMIT NO. G-681

IN NAME OF  
A. J. VEY

SURVEYED JUNE 27, 1966 BY L. GOULD