


T.8S.R.6W.W.M.

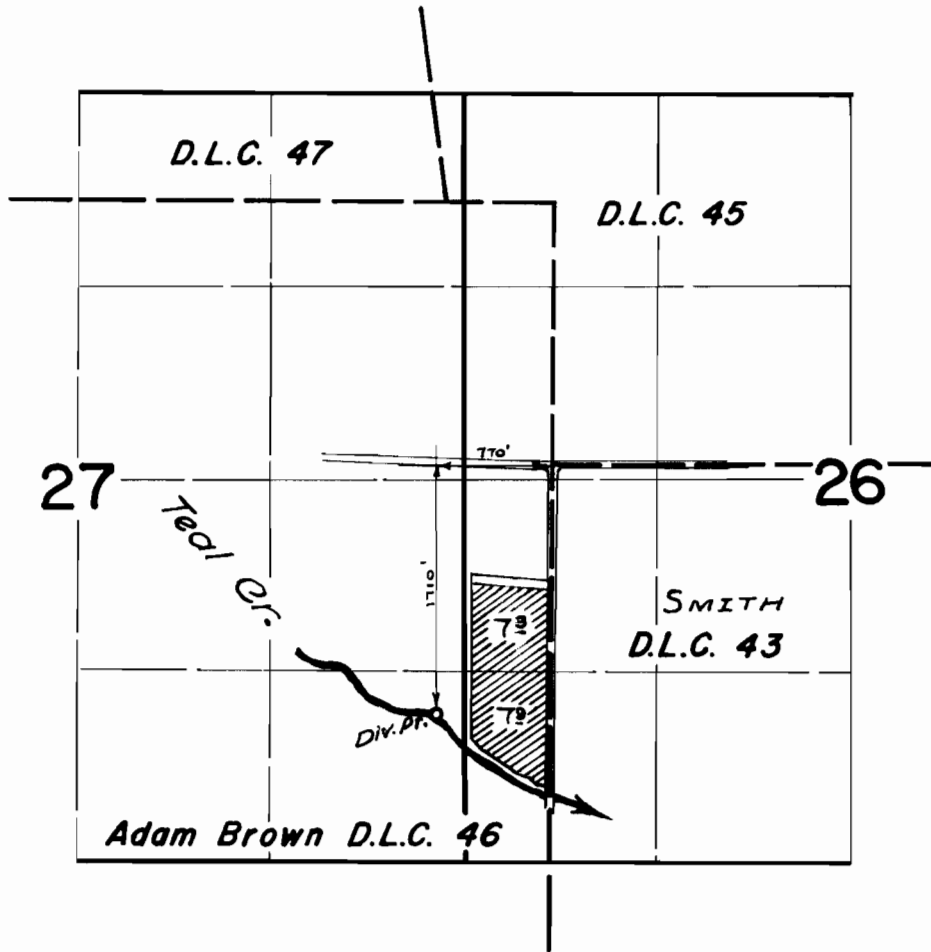

FINAL PROOF SURVEY
UNDER

Application No. **42029** Permit No. **31239**
IN NAME OF

CARL BARNARD

Surveyed July 27, 1966, by *R. Jackson*