


T.8S. R.6W.W.M.

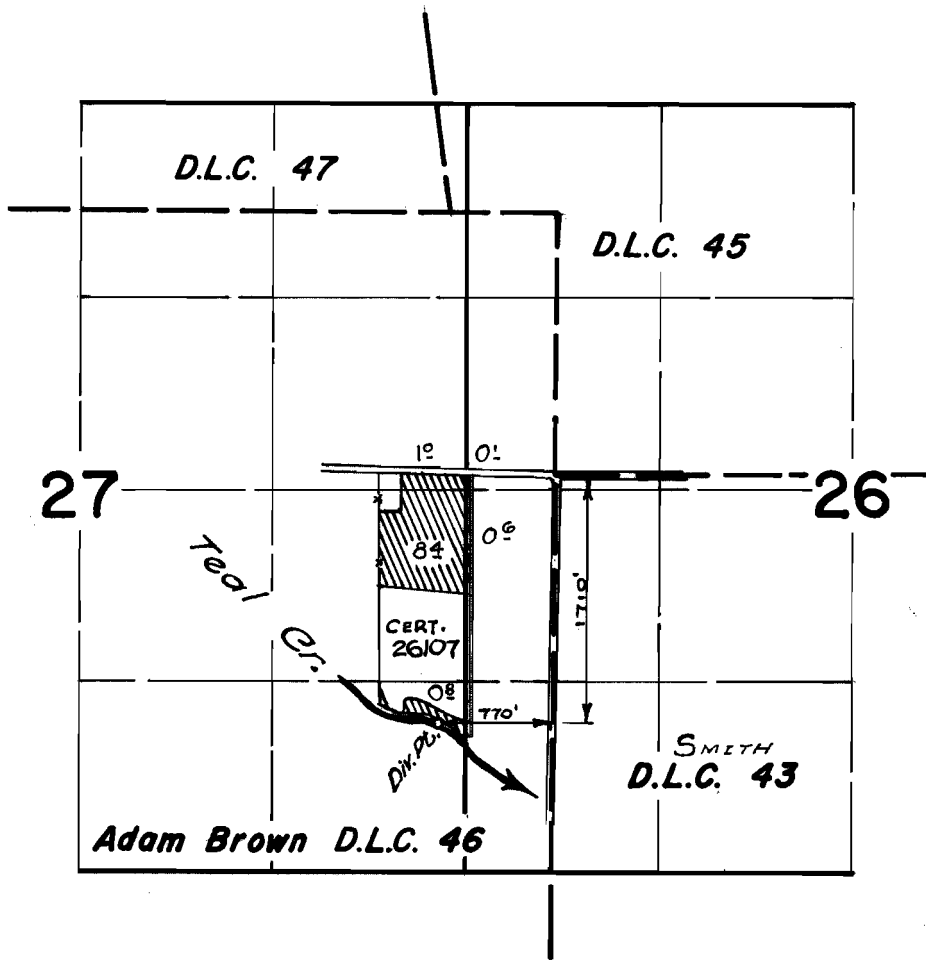

Application No. **39955**... Permit No. **29736**...
IN NAME OF

JACOB M. GREEN

Surveyed *July 27, 1966*, by *[Signature]*