


# T.5S.R.4W.W.M.

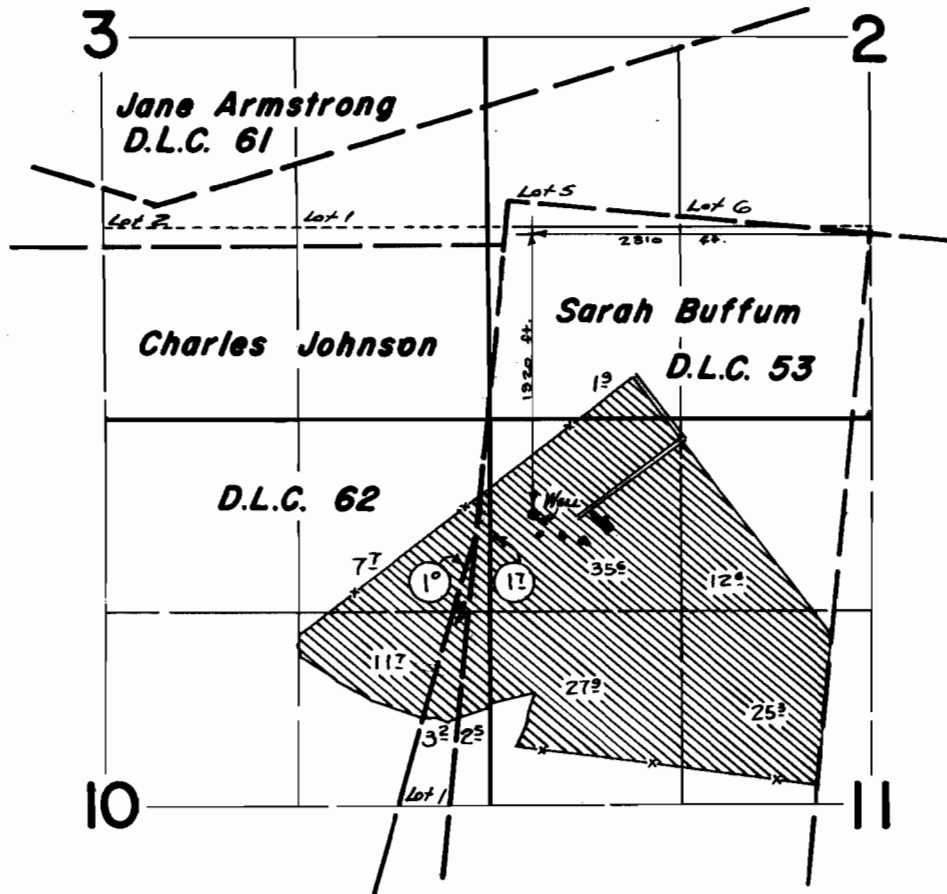

## FINAL PROOF SURVEY UNDER

Application No. ~~G-2609~~ Permit No. ~~G-2423~~  
IN NAME OF

NORMAN LONGHURST

Surveyed August 4 1965, by [Signature]