


# T.5S.R.3W.W.M.

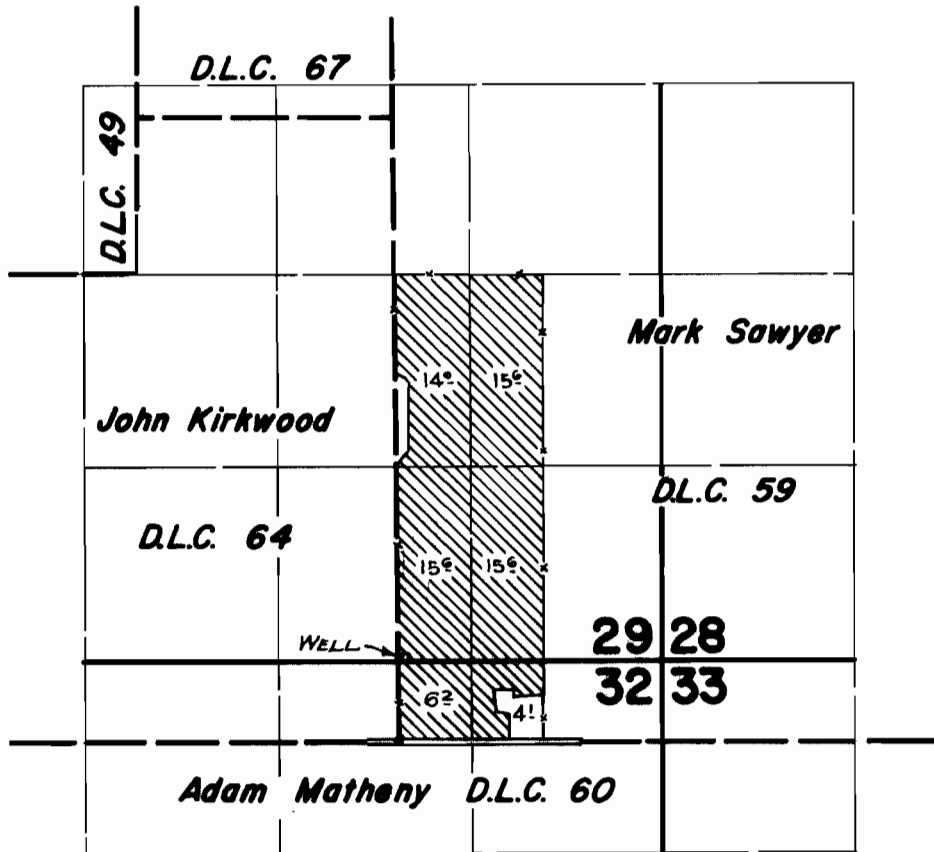

## FINAL PROOF SURVEY UNDER

Application No. G-2263 Permit No. G-2079  
IN NAME OF

F. L. WITHEE

Surveyed 7/29 & 8/2 1965, by *[Signature]*