


# T.5S.R.6W.W.M.

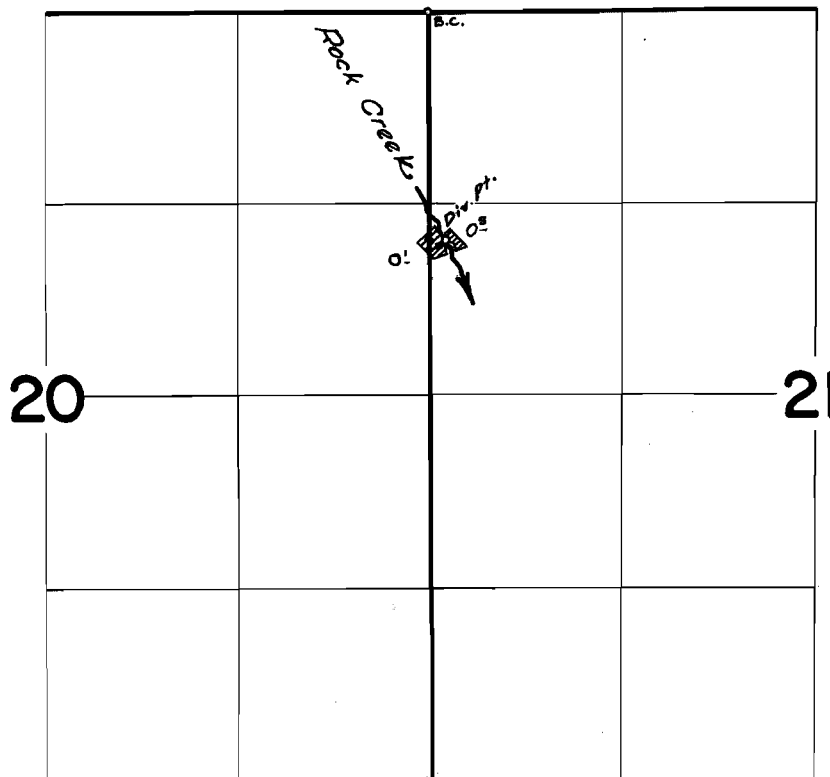

*Dir. Pt. is located 1560 ft. South & 110 ft. East from N.W. Cor.  
Section 21*

## FINAL PROOF SURVEY UNDER

Application No. 40411 Permit No. 30129  
IN NAME OF

REINHOLDT F. WERTH

Surveyed *July 28 1965* by *[Signature]*