


T.4 S.R.4 W.W.M.

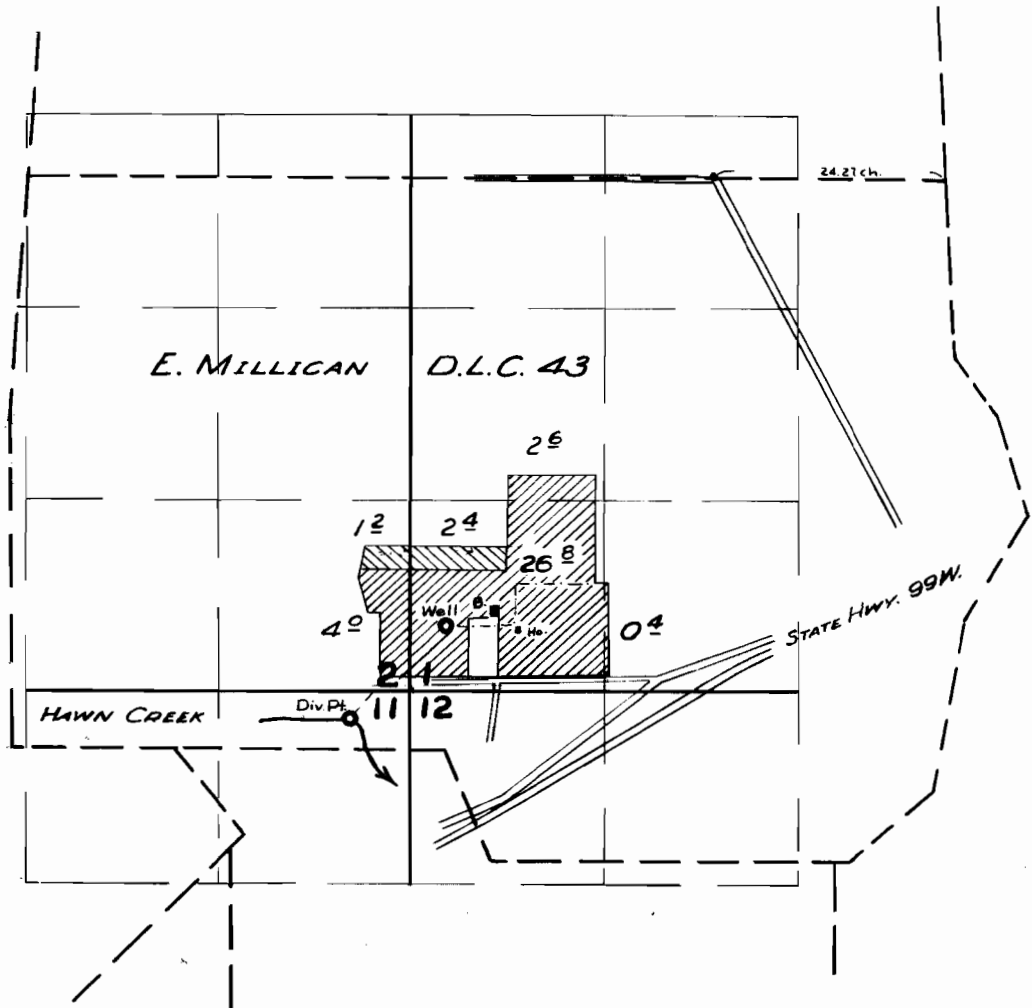

FINAL PROOF SURVEY UNDER

Application No. G-155 31354 Permit No. G-119 24701
IN NAME OF

F. H. BOURLAND

Surveyed 27 MAY 1960, by T. B. Bick