


T.3S.R.18&2E.W.M.

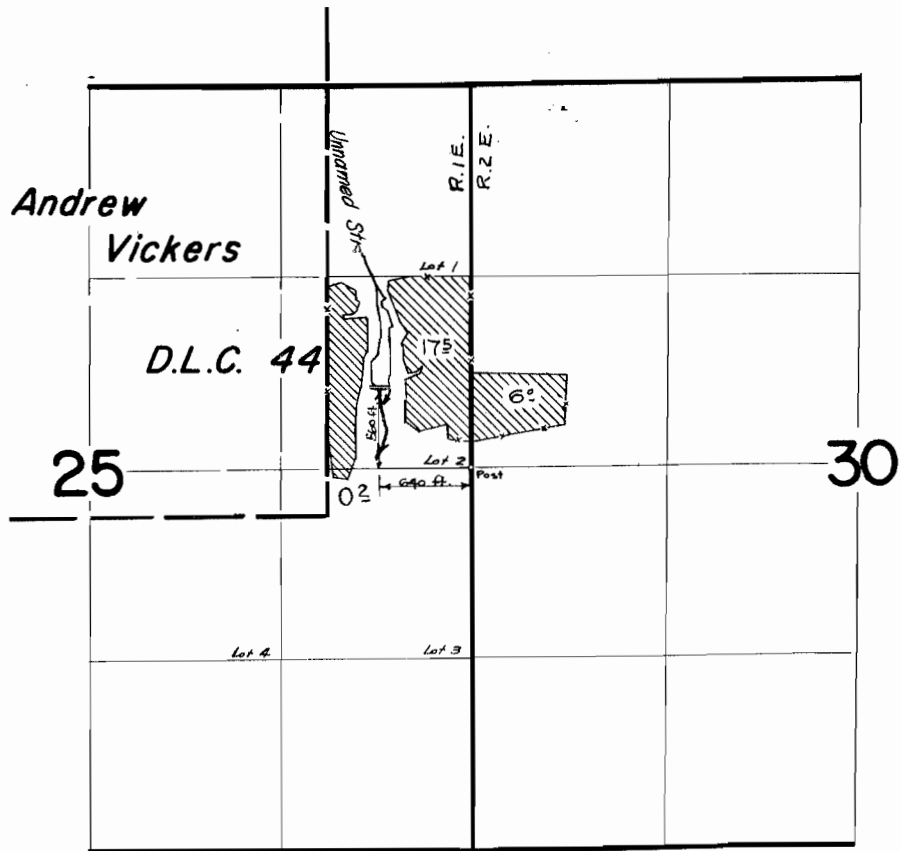

FINAL PROOF SURVEY UNDER

R-37011 R-2659
Application No. 37012... Permit No. 27559...
IN NAME OF

..... ALLEN GEORGE

Surveyed *May 11*... 1965, by *R. Jackson*