


T.4S.R.2&3E.W.M.

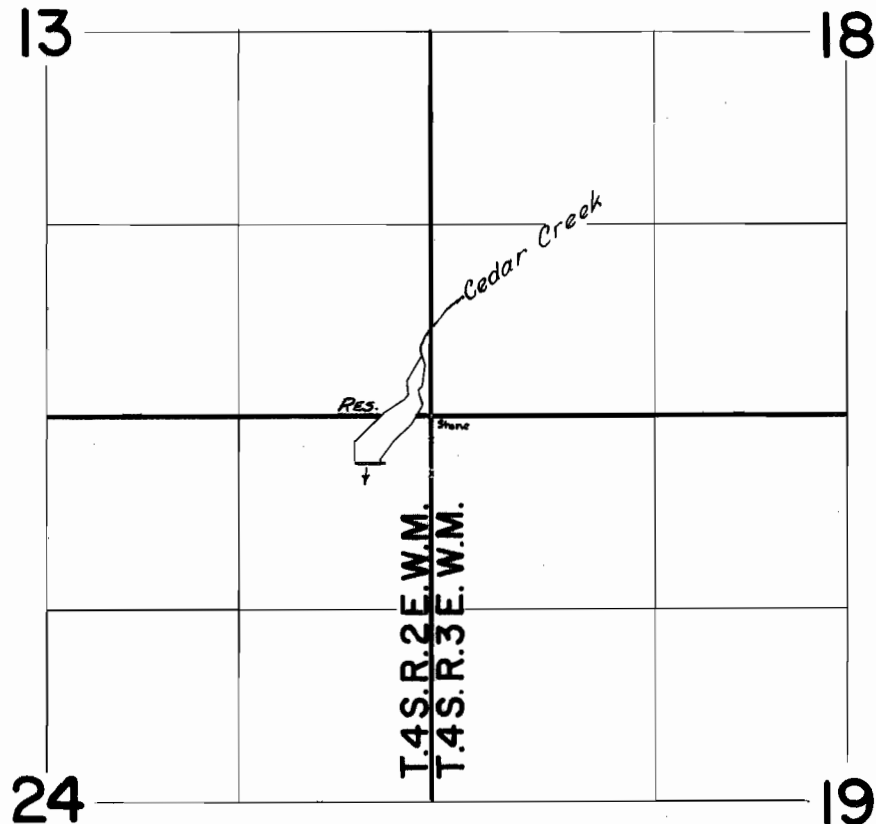

FINAL PROOF SURVEY
UNDER

Application No. R-37381 Permit No. R-2742
IN NAME OF

H. V. GILLILAND

Surveyed April 16, 1965, by [Signature]