


T.3&4S.R.1E.W.M.

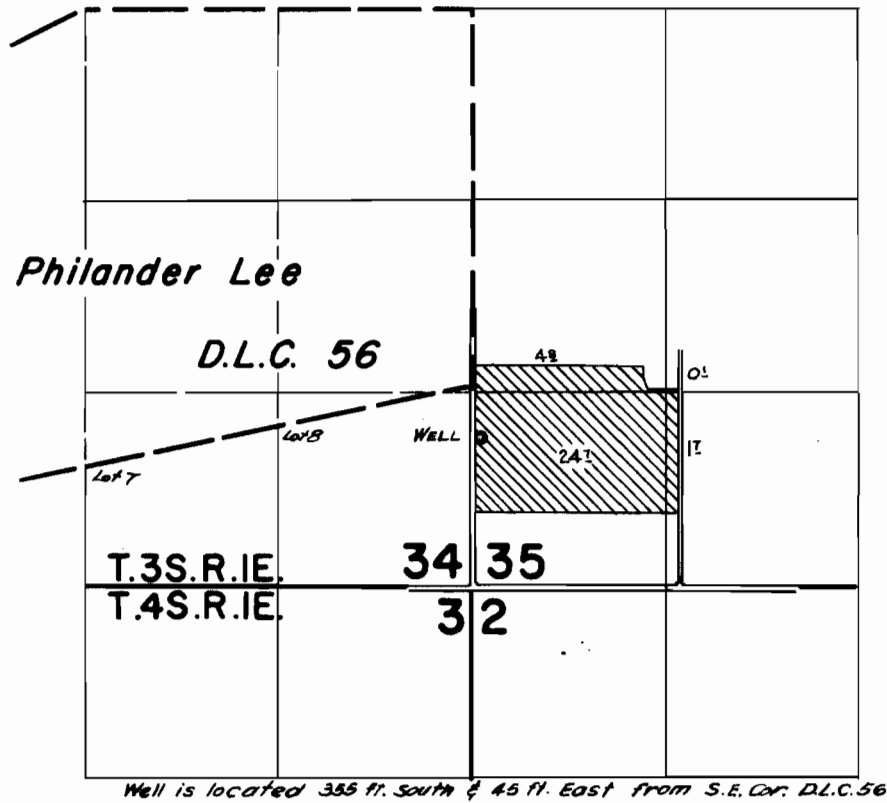

FINAL PROOF SURVEY UNDER

Application No. G-2161... Permit No. G-1994
IN NAME OF

EMIL KRAFT

Surveyed April 23 1965, by *R. Jackson*