


T.2S. R.4 E. W.M.

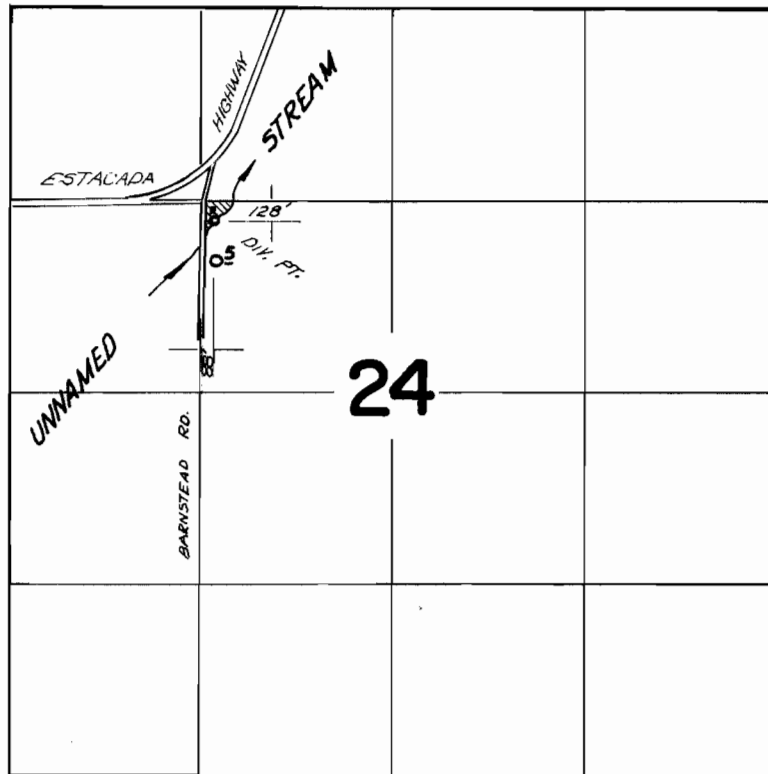

FINAL PROOF SURVEY
UNDER

Application No. 39828 Permit No. 29596
IN NAME OF

ADOLPH KOTZMAN

Surveyed Aug 23 1966, by V. GARNER