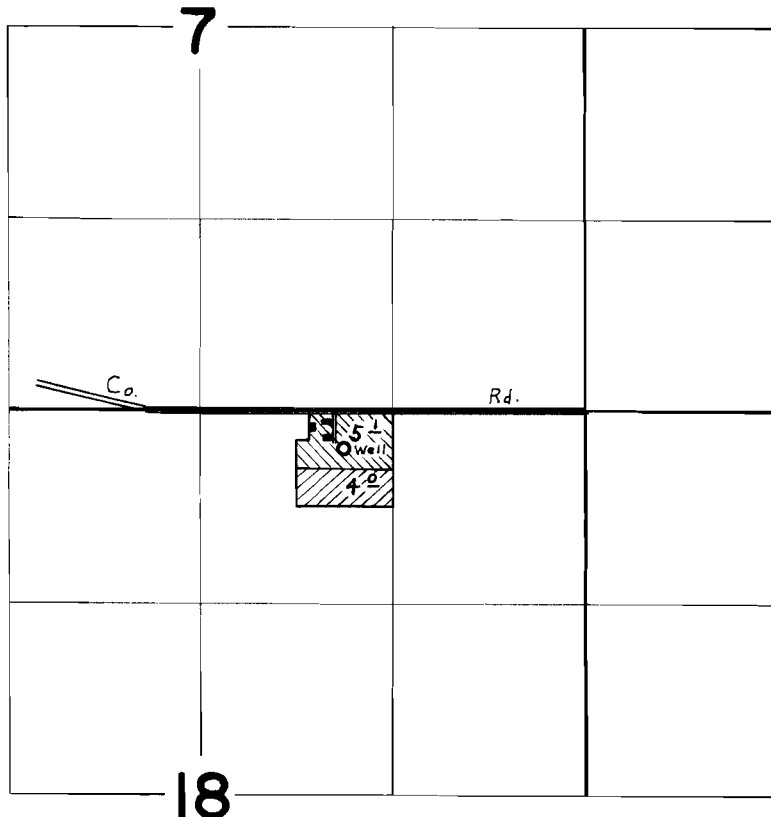

 


T.4S.R.1E.W.M.



Well Located 330' W. & 260' S. From N.E. Cor., N.W. $\frac{1}{4}$, N.E. $\frac{1}{4}$, Sec. 18

Primary 
Supplemental 

FINAL PROOF SURVEY UNDER

Application No. G-2622 Permit No. G-2483
IN NAME OF

JOHN MITSCH

Surveyed Oct. 20, 1966, by L. E. Gould