


T.6S.R.1E.W.M.

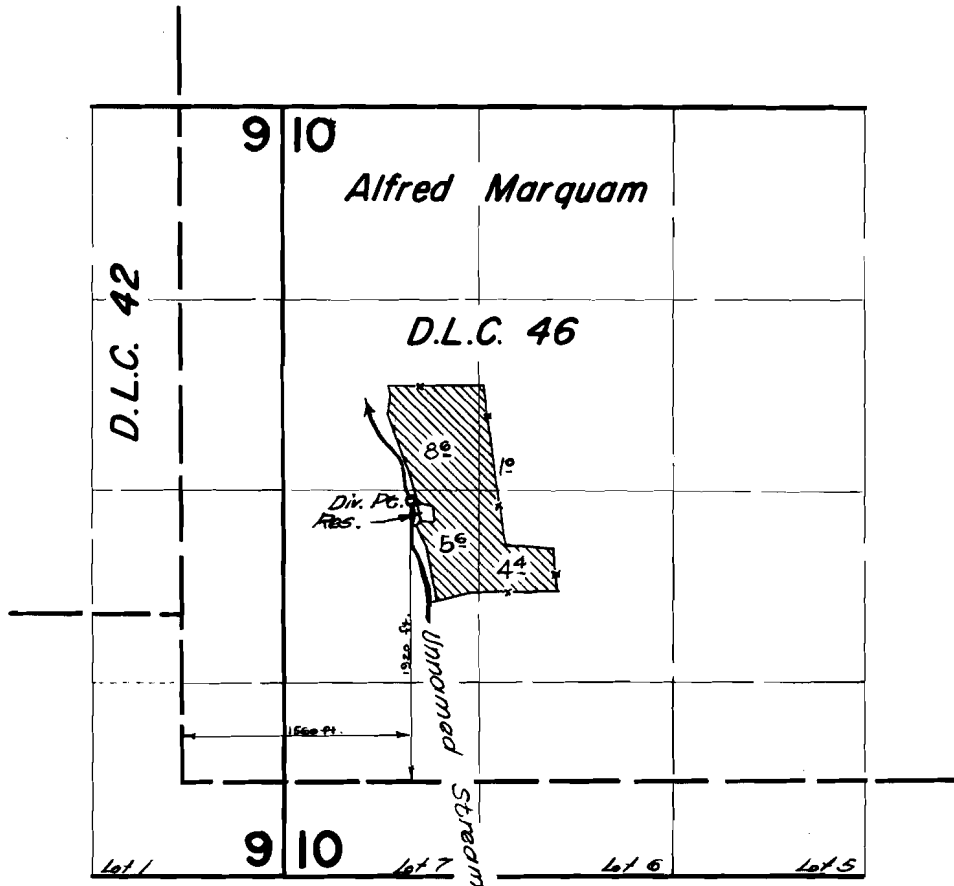

FINAL PROOF SURVEY
UNDER

R-38336 R-3199
Application No. **38337**... Permit No. **28536**...
IN NAME OF

CLIFFORD SWARTOUT

Surveyed August 16 1965, by *R. Jackson*