


T.3S. R.5E. W.M.

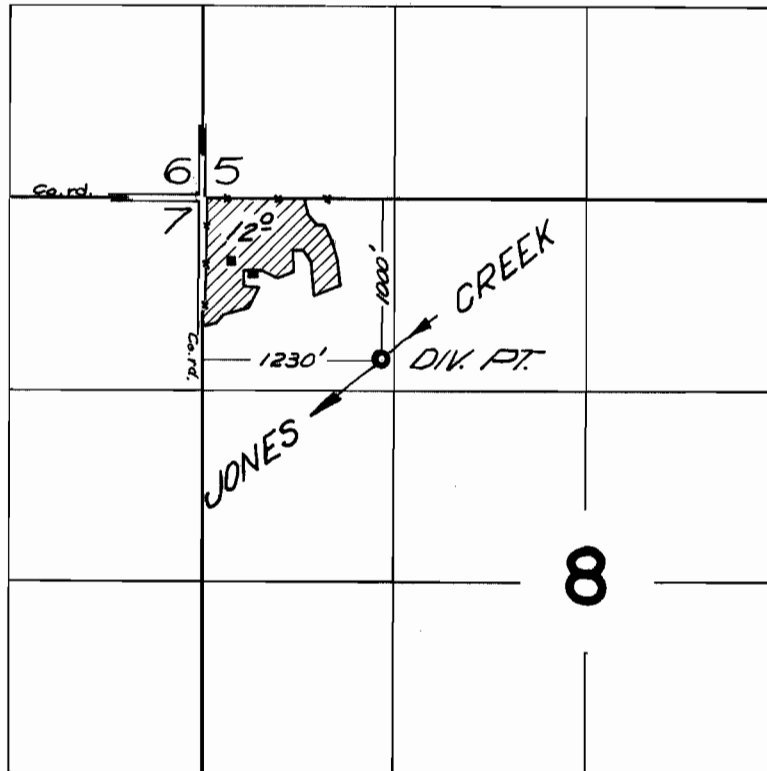

FINAL PROOF SURVEY
UNDER

Application No. 37/34 Permit No. 27665
IN NAME OF

ROGER STEWART

Surveyed Aug 25 1966, by V. GARNER