


T.6S.R.1E.W.M.

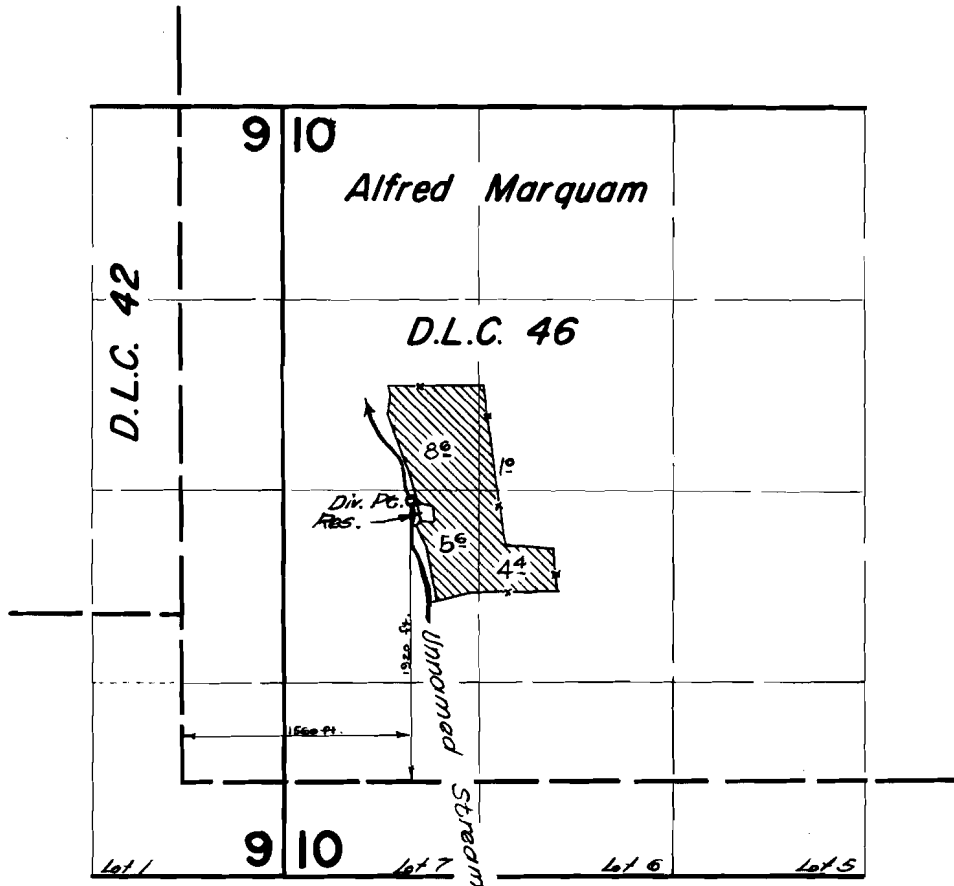

FINAL PROOF SURVEY UNDER

R-38336 R-3199
Application No. 38337... Permit No. 28536...
IN NAME OF

CLIFFORD SWARTOUT

Surveyed August 16 1965, by *R. Jackson*