


T.5S.R.1E.W.M.

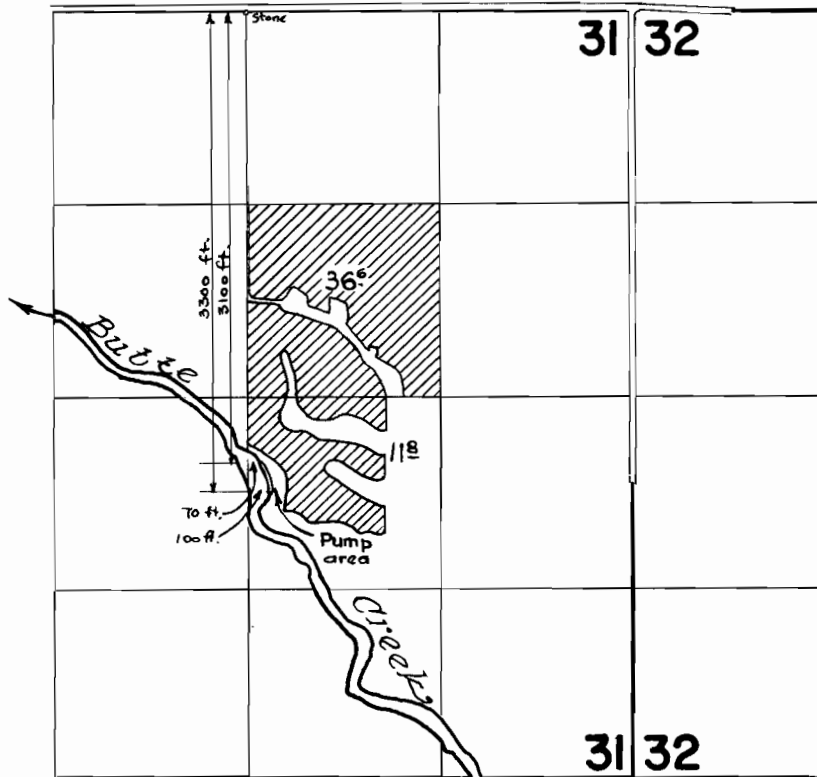

FINAL PROOF SURVEY UNDER

Application No. **34583** Permit No. **27159**....
IN NAME OF

CHRIS RAMBERG

Surveyed *April 23* 1965, by *R. Jackson*