


T.6S.R.2E.W.M.

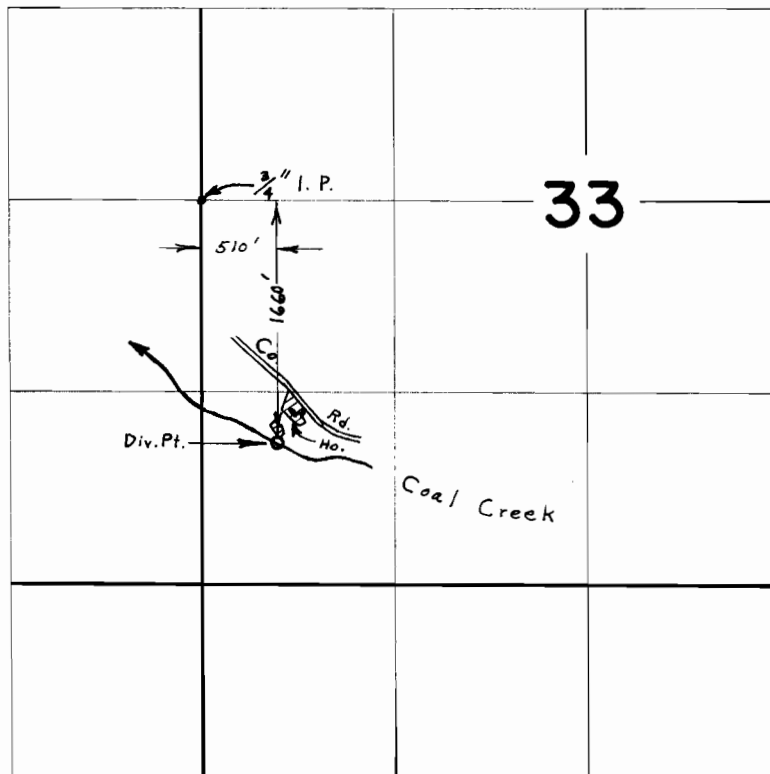

FINAL PROOF SURVEY
UNDER

Application No. 41407 Permit No. 30930
IN NAME OF

LEONARD E. SKINNER

Surveyed Sept. 28, 1966, by L. E. Gould