


T.28S.R.12W.W.M.

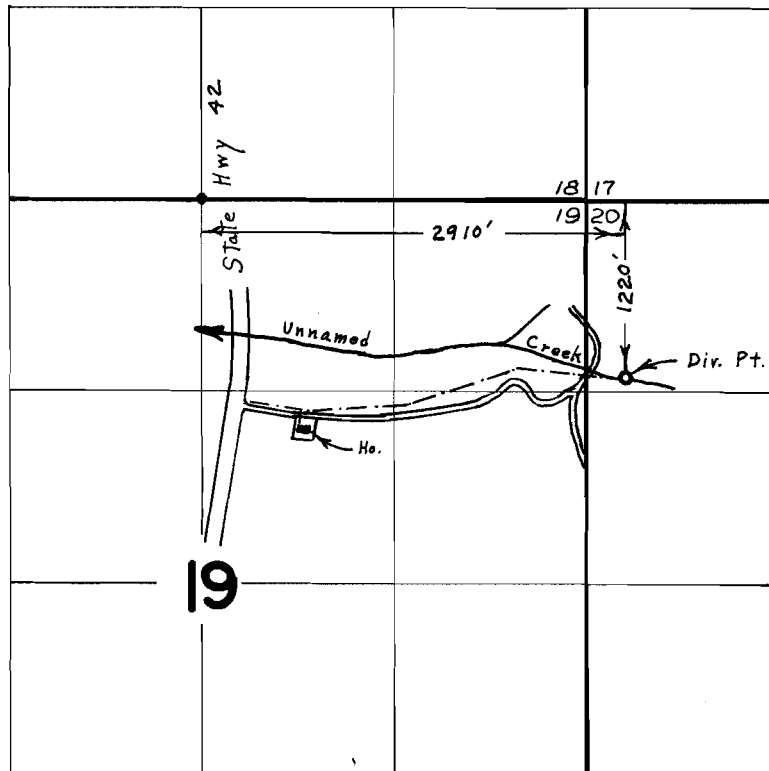

FINAL PROOF SURVEY
UNDER

Application No. 40106 Permit No. 29901
IN NAME OF

DELLA W. ADAMEK

Surveyed Oct. 12, 1966, by L. E. Gould