


# T.28S.R.12&13W.W.M.

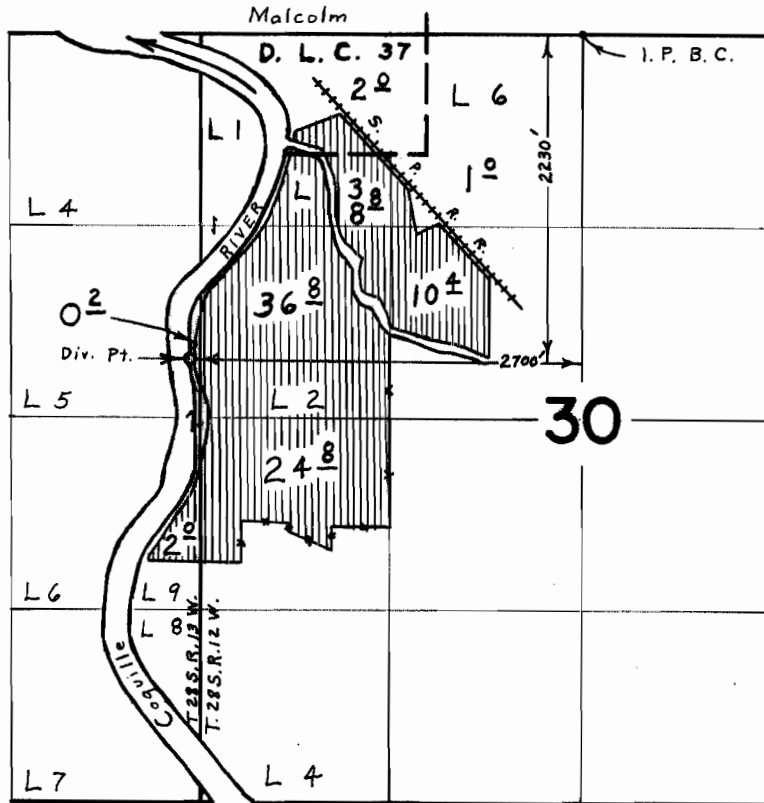

## FINAL PROOF SURVEY UNDER

Application No. 39714 Permit No. 29485  
IN NAME OF

**ROBERT T. DETLEFSEN**

Surveyed Oct. 13, 1966, by L. E. Gould