


T.28S.R.12&13W.W.M.

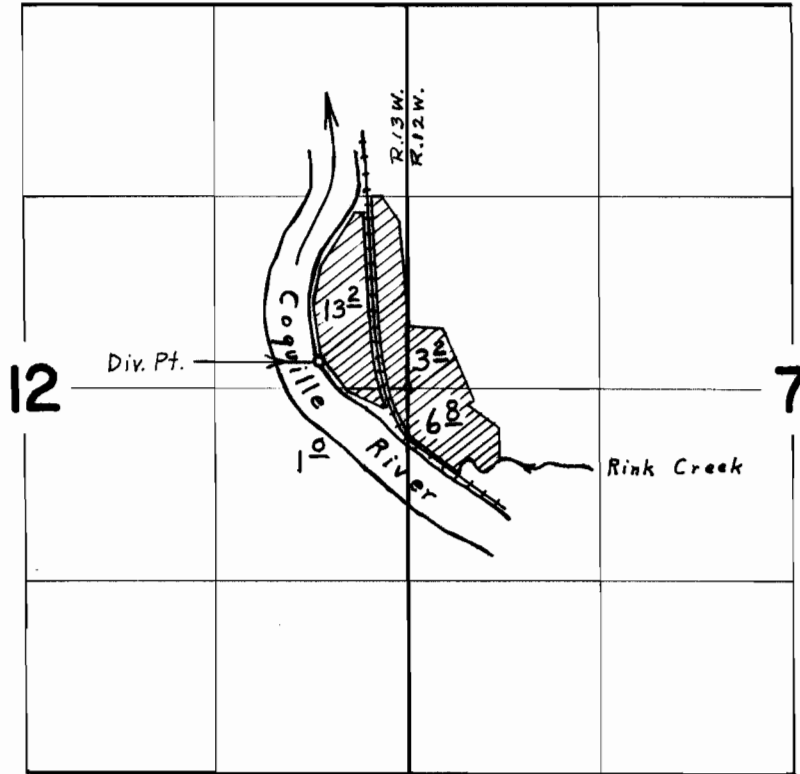

Div. Pts. Located 180' N. & 600' W. from The W $\frac{1}{4}$ Cor. Sec. 7

FINAL PROOF SURVEY
UNDER

Application No. 39455 Permit No. 29297
IN NAME OF

EARL F. & OR CHARLOTTE JACOBSEN

Surveyed Oct. 12, 1966, by L. E. Gould