


T.25S.R.IIW.W.M.

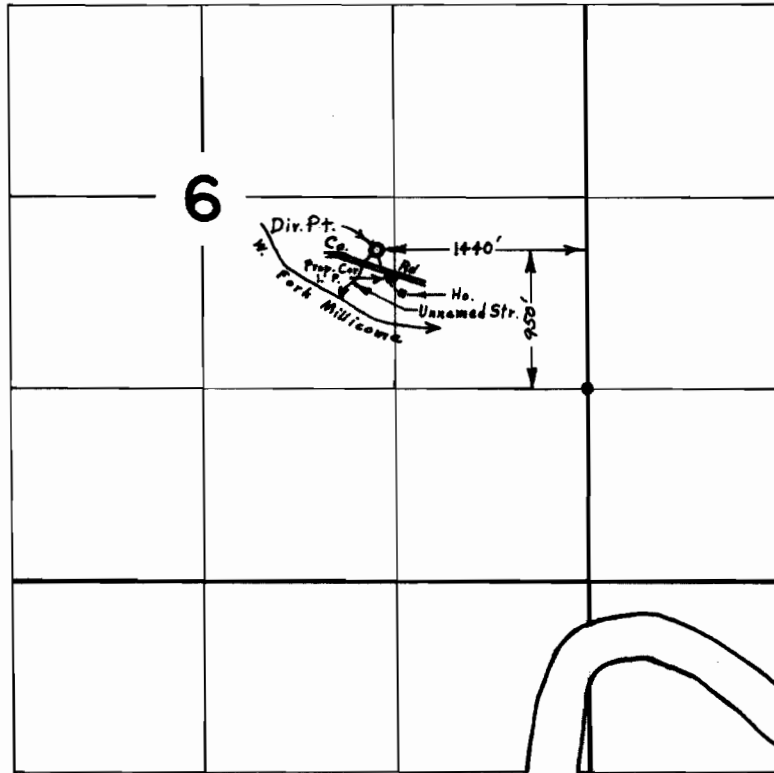

FINAL PROOF SURVEY UNDER

Application No. 34737 Permit No. 27275
IN NAME OF

WILLIAM F. & HATTIE J. STORY

Surveyed Sept. 22, 1966, by L. E. Gould