


T.17S. R.21E. W.M.

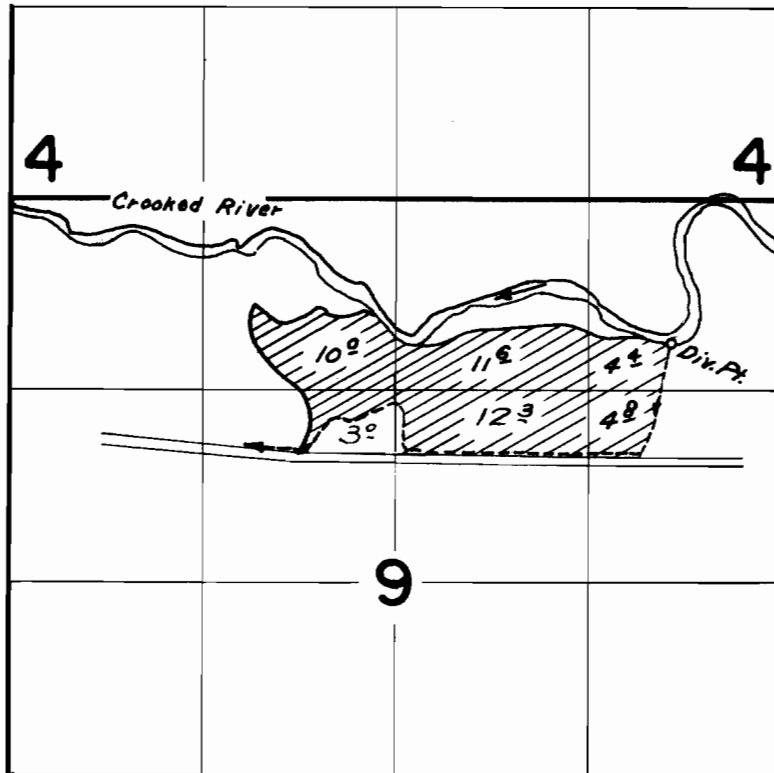

FINAL PROOF SURVEY
UNDER

Application No. 30509 Permit No. 24022
IN NAME OF

D. C. MAINE

Surveyed Oct. 6, 1964, by R. Jackson