


T.27S.R.5W.W.M.

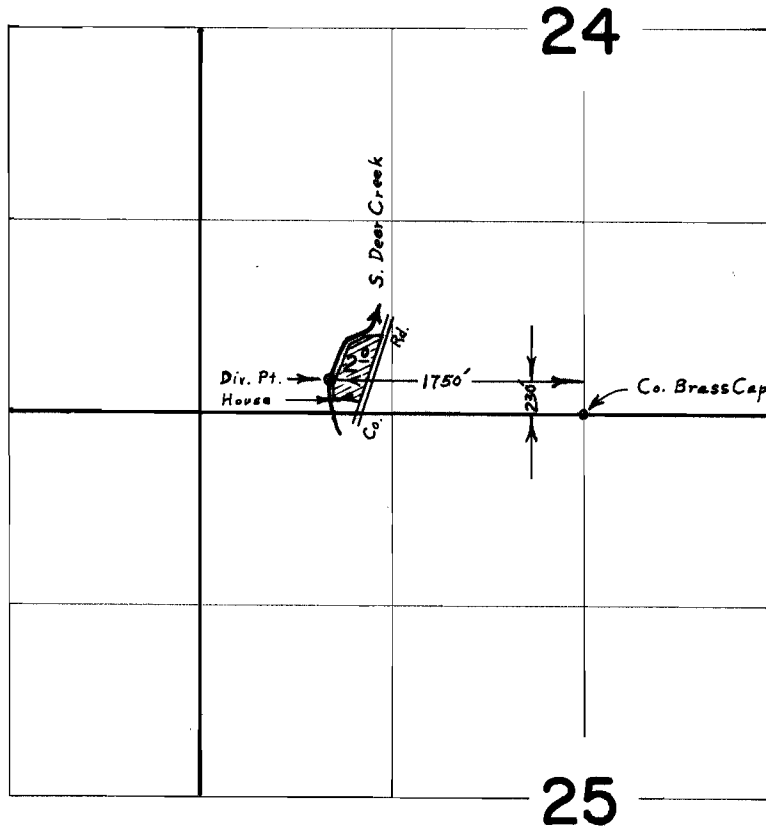

FINAL PROOF SURVEY UNDER

Application No. 38178 Permit No. 28456
IN NAME OF

VERNON V. STURDEVANT

Surveyed May 18, 1966, by L. E. Gould