T.27S.R.5W.W.M.

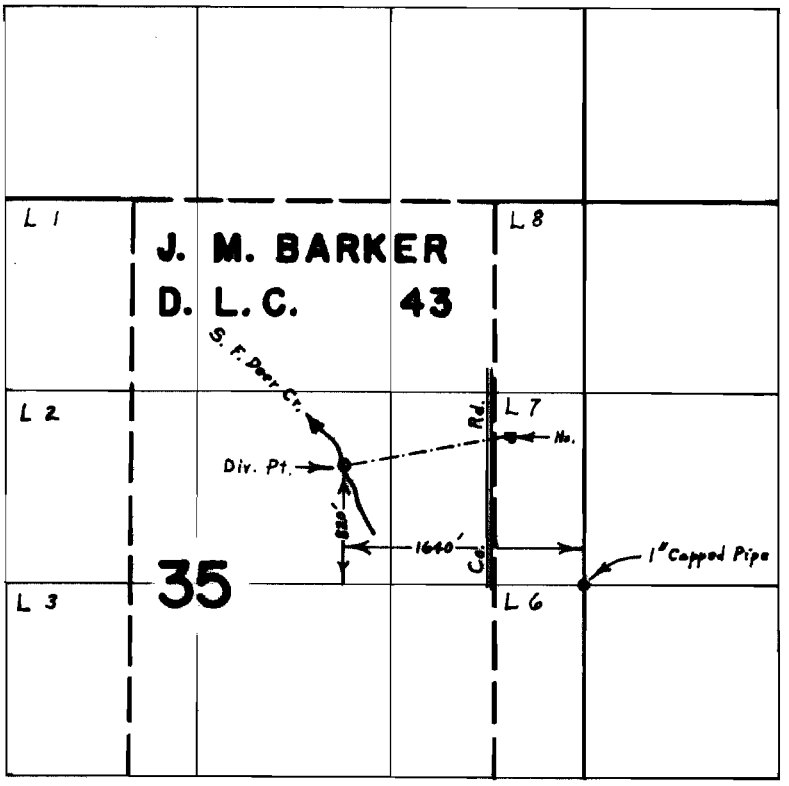

FINAL PROOF SURVEY
UNDER

Application No. 41293 Permit No. 30833
IN NAME OF

ERNEST & AGNES WEBER

Surveyed May 18 1966, by L. E. Gould

1966-S