


T. 10 S. R. 30 E. W.M.

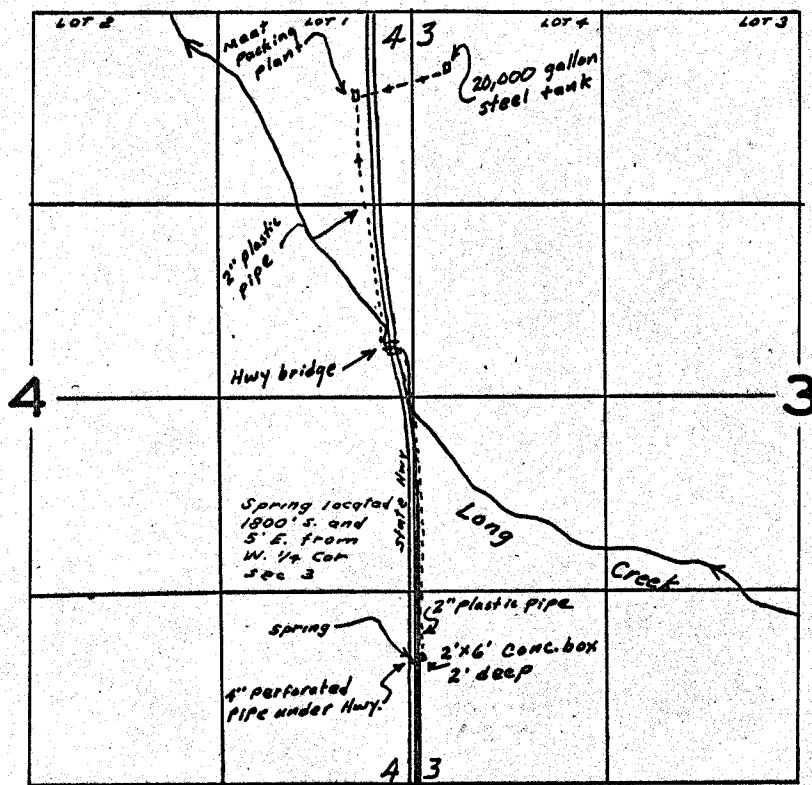

FINAL PROOF SURVEY UNDER

Application No. 33265 Permit No. 26343
IN NAME OF

Longcreek Meat Co.

Surveyed 6-29 1965, by G. Ward