


T. 39 S. R. 35 E. W.M.

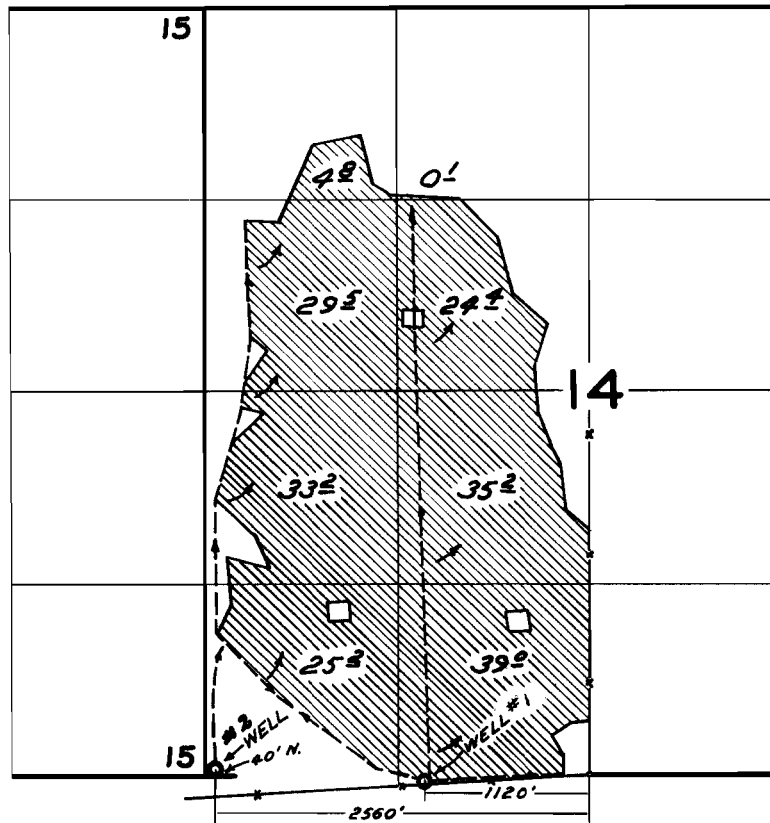

FINAL PROOF SURVEY
UNDER

Application No. C-2365 Permit No. G-2928
IN NAME OF

MRS. C. ORLANDO, & D. & F. ORLANDO

Surveyed Oct. 27, 1965, by R. JACKSON