


T. 40S. R. 36E. W.M.

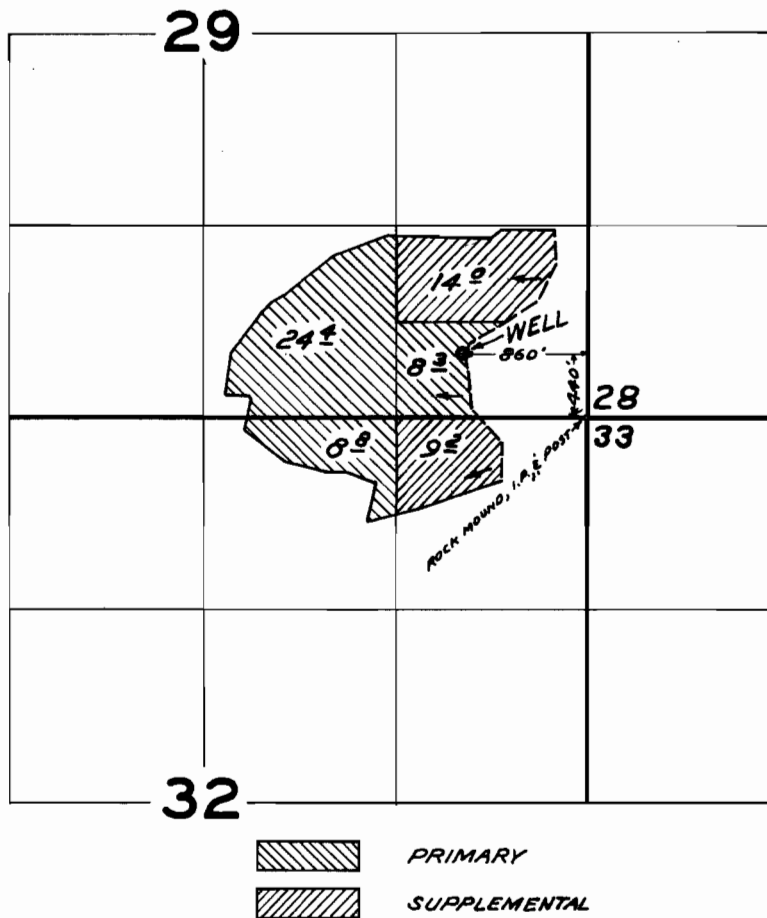

FINAL PROOF SURVEY
UNDER

Application No. G-2366 Permit No. G-2181
IN NAME OF
ESTATE OF E. F. SMITH
c/o W. D. SHERBURN

Surveyed Oct. 26, 1965, by R. JACKSON