


T.34S.R.IW.W.M.

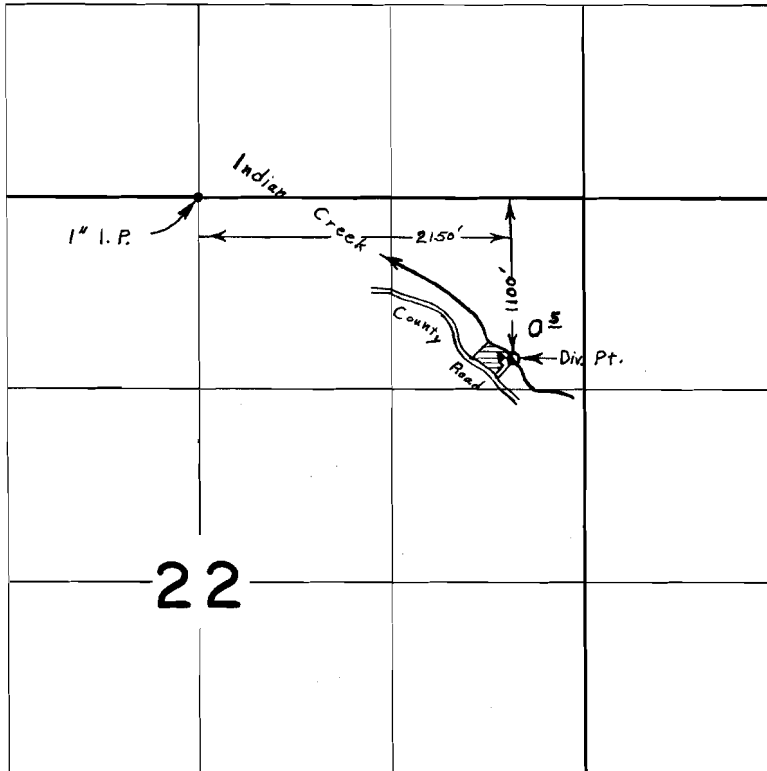

FINAL PROOF SURVEY
UNDER

Application No. 40108 Permit No. 29903
IN NAME OF

EDWARD AND DOROTHY L. ANSEMI

Surveyed July 15, 1966, by L. E. Gould