


T.34S.R.IW.W.M.

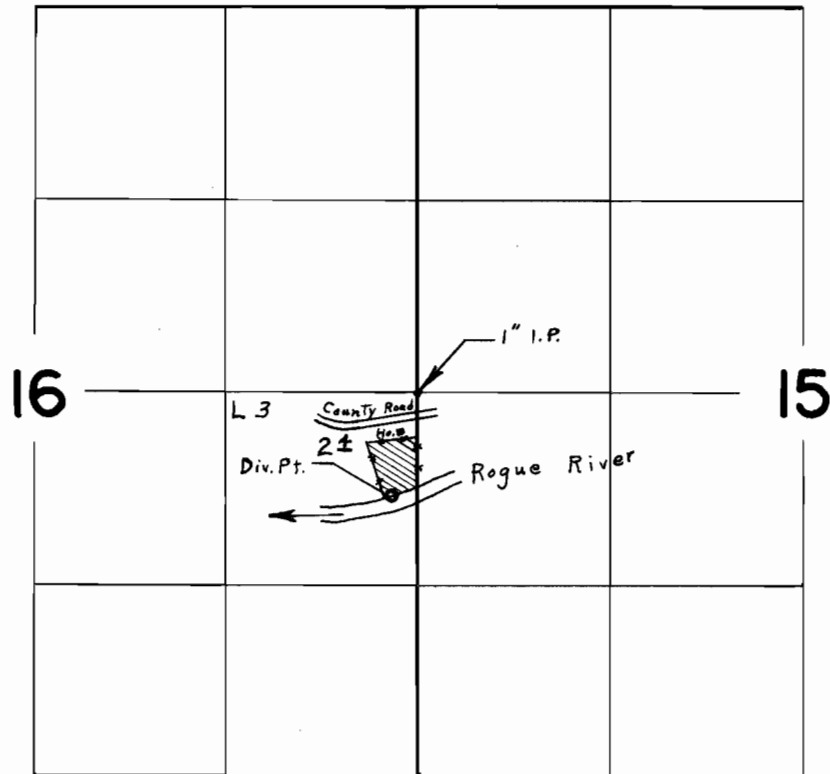

Div. Pt. Located 170' W. & 710' S. From E. $\frac{1}{4}$ Corner Section 16

FINAL PROOF SURVEY
UNDER

Application No. 37689 Permit No. 28086
IN NAME OF

VERNON D. OR ALBERTA CHAMBERLAIN

Surveyed July 13 1966, by L. E. Gould