


T.36S.R.4W.W.M.

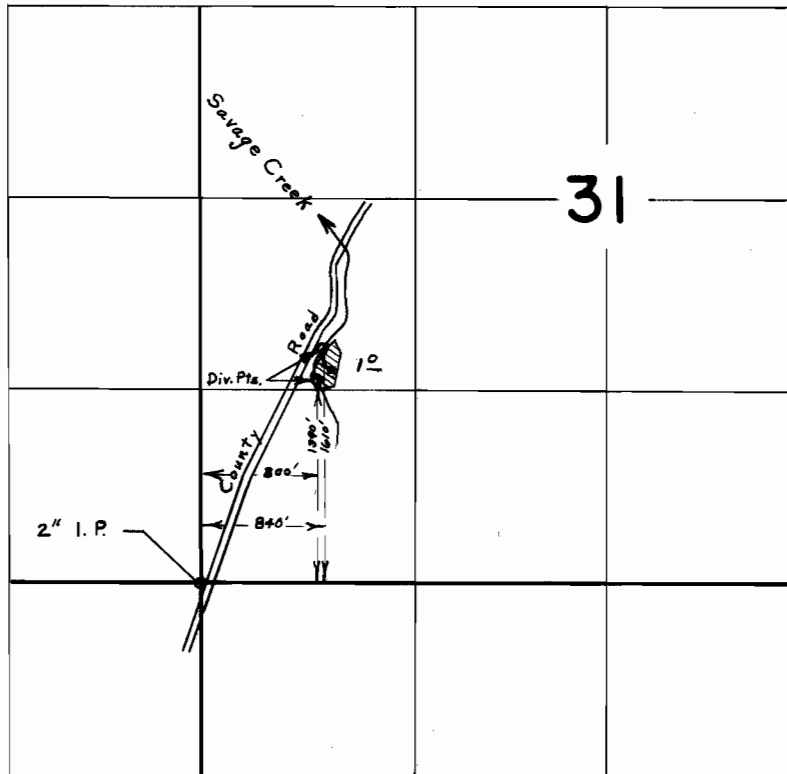

FINAL PROOF SURVEY
UNDER

Application No. 38996 Permit No. 29050
IN NAME OF

MARY E. CUDDY

Surveyed June 7, 1966, by R. E. Gould