


# T.36S.R.4W.W.M.

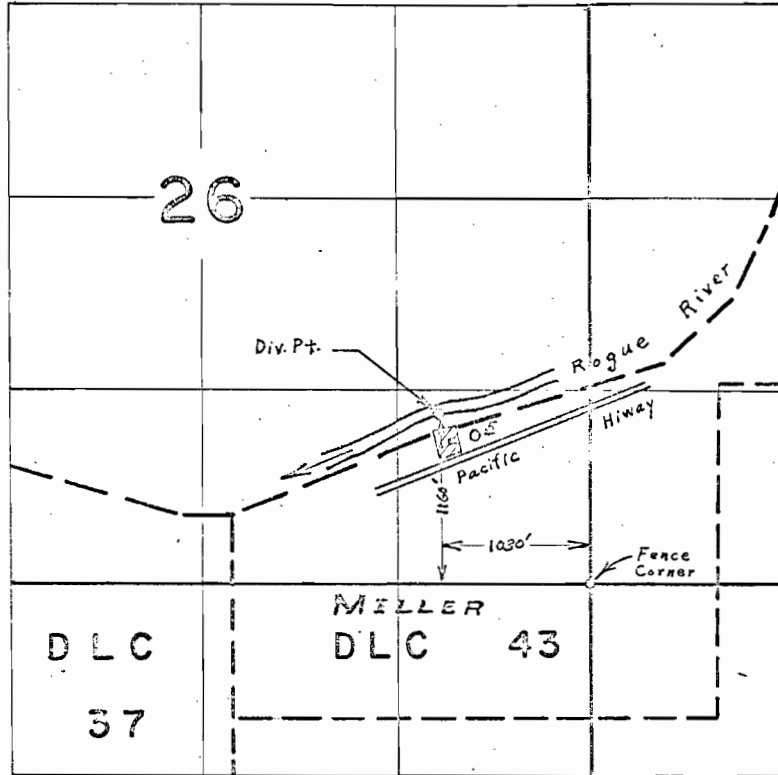

## FINAL PROOF SURVEY UNDER

Application No. 38663 Permit No. 28902 CERT. 34240  
IN NAME OF

LAVERNE H. & MARGARET I. MORSE

Surveyed June 4, 1966, by L. E. Gould

1966-T