


T.36S.R.4W.W.M.

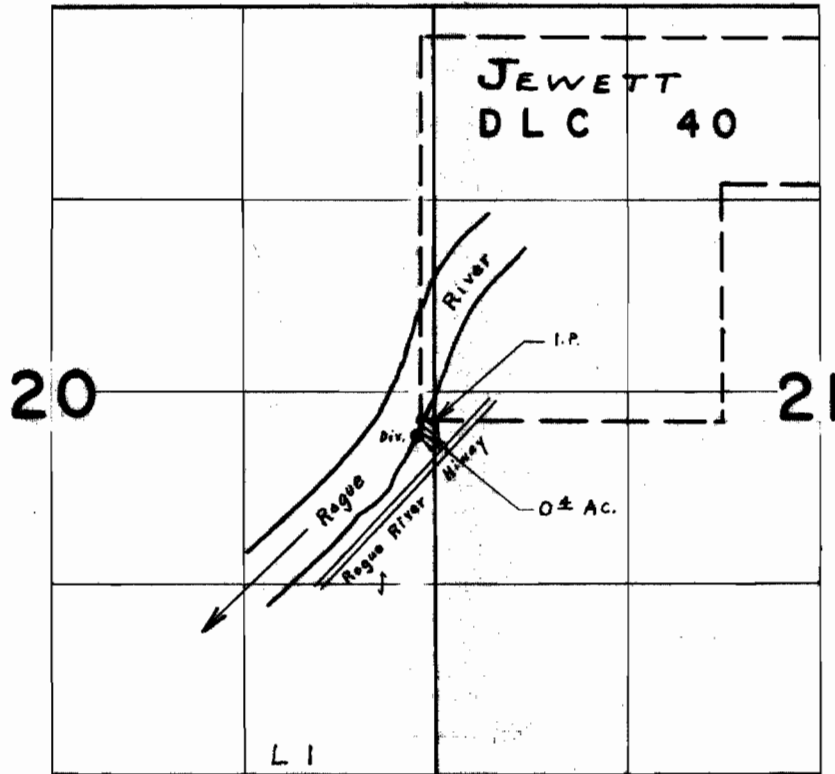

Div. Pt. Located 30' W. & 110' S. From S.W. Cor. DLC #40

FINAL PROOF SURVEY
UNDER

Application No. 37071 Permit No. 27649
IN NAME OF

HARRY D. OGBORN

Surveyed June 8 1966, by L. E. Gould