


T.36S.R.4W.W.M.

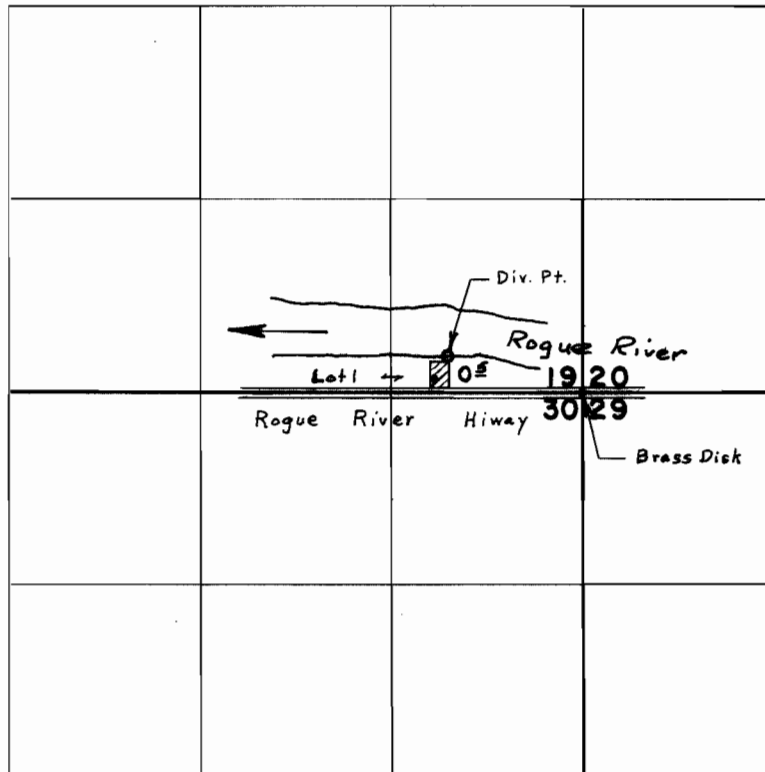

Div. Pt. Located 920' W. & 250' N. From S.E. Cor. Sec. 19

FINAL PROOF SURVEY
UNDER

Application No. 37700 Permit No. 28182
IN NAME OF

WALLACE B. & LAVITA H. ROBERTSON

Surveyed June 8, 1966, by L. C. Gould