


T.36S.R.4W.W.M.

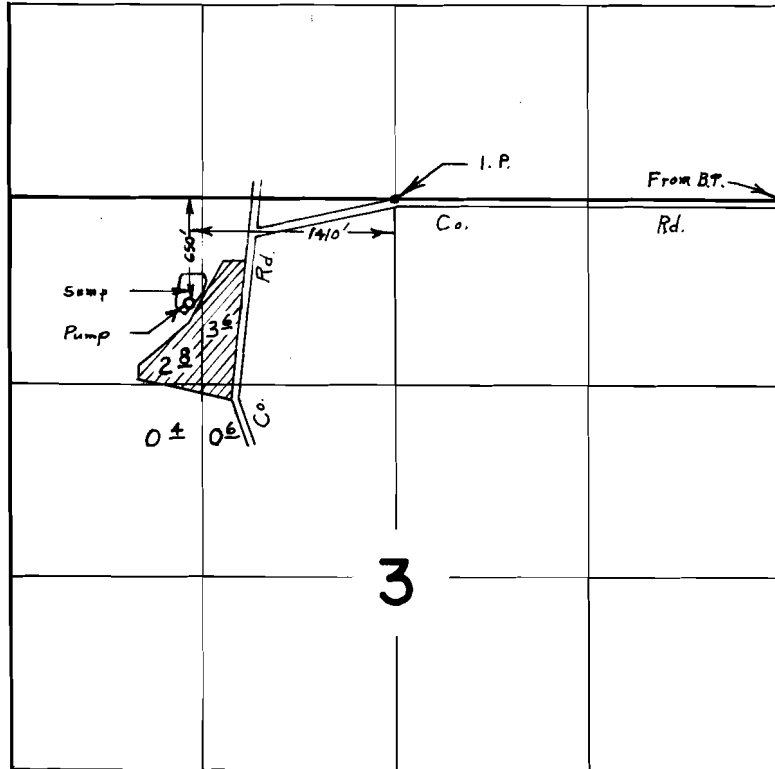

FINAL PROOF SURVEY UNDER

Application No. G-3025 Permit No. G-2814
IN NAME OF

THOMAS O. TATE

Surveyed June 8, 1966, by L. E. Gould