


# T. 38 SR. 8 W. W.M.

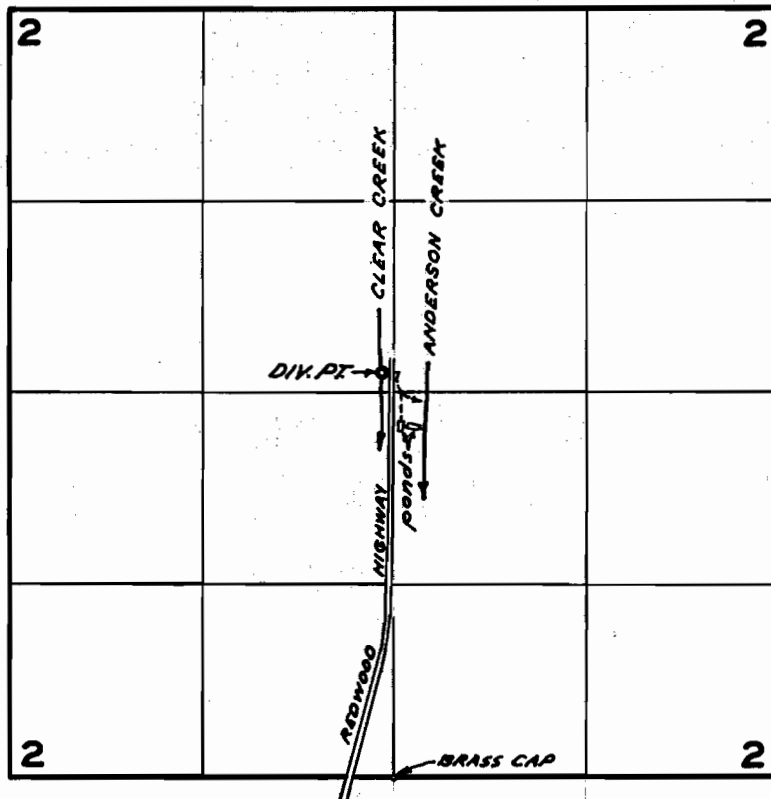

DIV. PT. LOCATED 2780 ft N. & 80 ft W. FROM S. 1/4 COR

## FINAL PROOF SURVEY UNDER

Application No. R-33940 34020 Permit No. R-2366 26830  
IN NAME OF

MERVYN WILLIAM HOGAN

Surveyed JUN 23 1966, by R. JACKSON