


T.38S.R.5W.W.M.

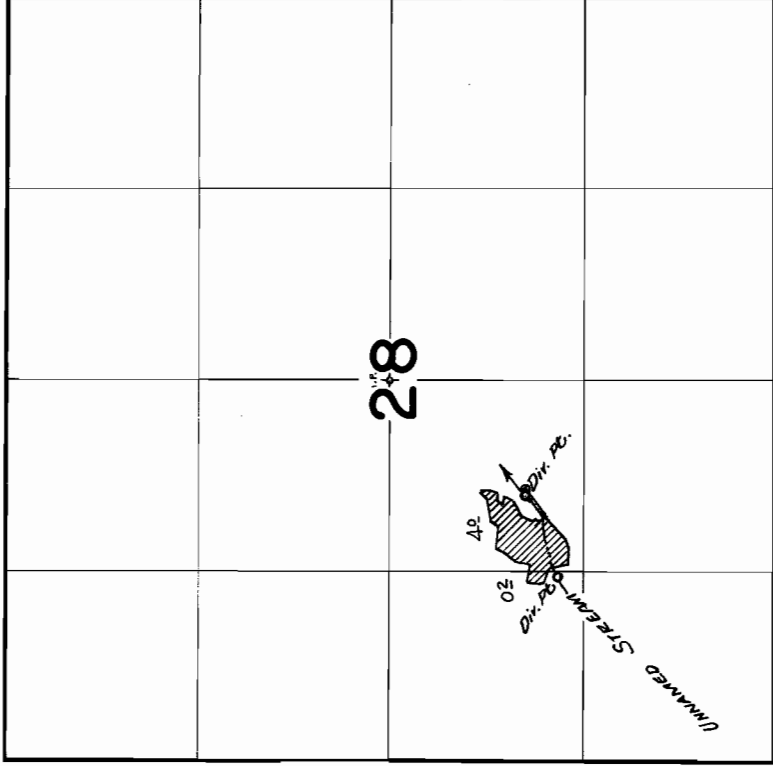

*Upstream div. pt. is located 1150 ft. South & 1340 ft. West from center Sec. 28  
Downstream div. pt. is located 920 ft. South & 790 ft. West from center Sec. 28*

**FINAL PROOF SURVEY**  
UNDER

Application No. 31577... Permit No. 25075  
IN NAME OF

**CHARLES E. & BLANCHE HOWE**

Surveyed July 17 1965, by *R. H. Jackson*




Center 1/4 Cor  
 Fed. 2" I.P. mkd. center section 28

# MAP

## DIVERSION POINTS AND IMPROVEMENTS HOWE PROPERTY

IN  
 N 1/2 SW 1/4 of SECTION 28  
 T. 38 S., R. 5 W., W.M.  
 Scale 1 in. = 400 ft. May 15, 1957

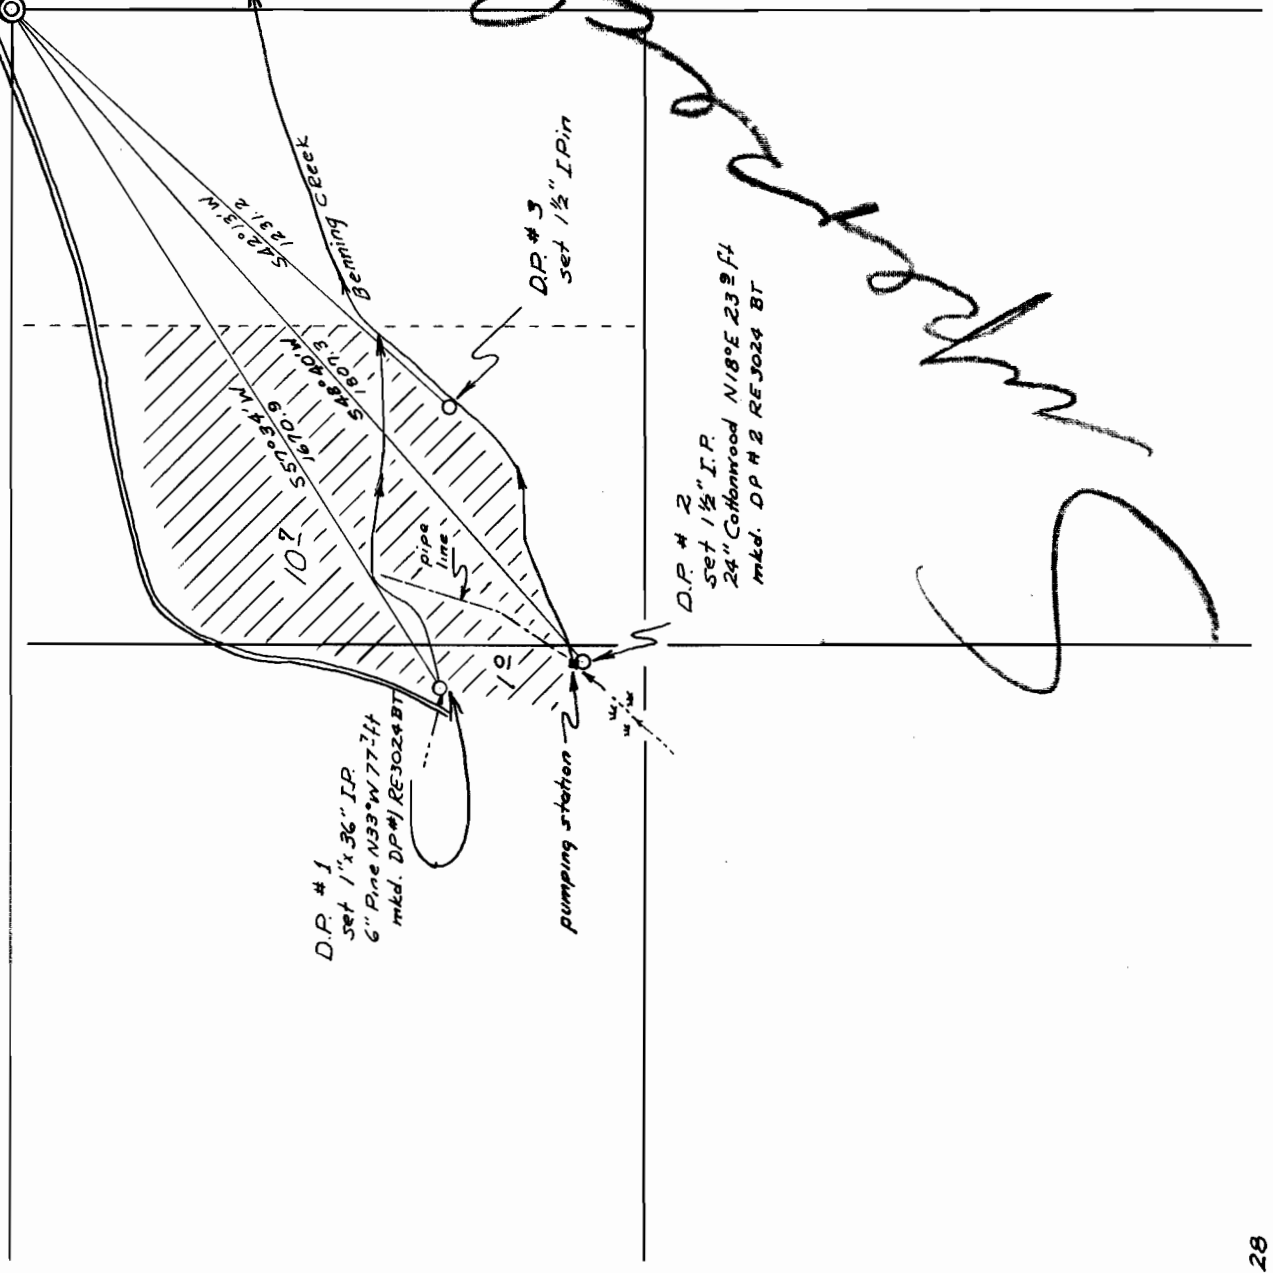

D.P. #1  
 mkd. DP #1 RE3024 BT

D.P. #2  
 set 1 1/2" I.P.  
 24" Cottonwood N18°E 23'± ft  
 mkd. DP #2 RE3024 BT

D.P. #3  
 set 1 1/2" I.P. in

I, Richard L. Templin of Grants Pass, Oregon do hereby certify that this map was made from notes taken during an actual survey made by me (or under my immediate supervision) on May 16, 1957; that monuments shown on this map are: Diversion Point No. 1 - 1 inch I.Pipe is S 57°34' W 1670.9 ft from center 1/4 corner section 28, Diversion Point No. 2 - 1 1/2 inch I. Pipe is S 48°40' W 1807.3 ft from center 1/4 corner section 28, Diversion Point No. 3 - 1 1/2 inch I. Pin is S 42°13' W 1231.2 ft from center 1/4 corner section 28

monuments O

