


T.35S.R.7W.W.M.

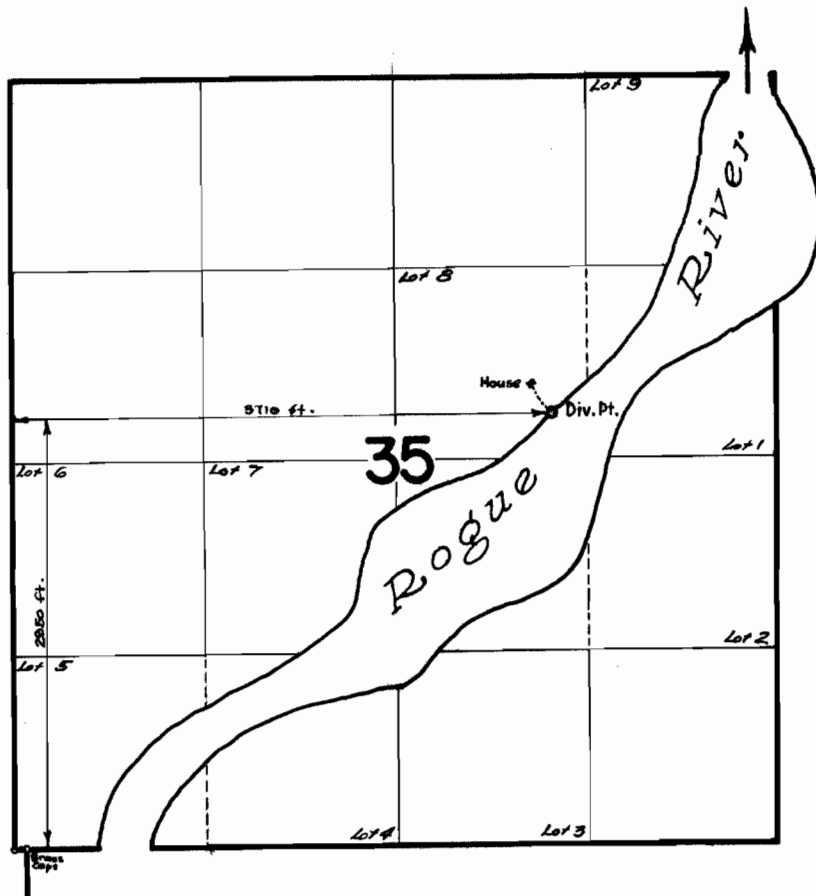

FINAL PROOF SURVEY
UNDER

Application No. 39519..... Permit No. 29403...
IN NAME OF

JOHN WALTER M'CLOUGHLIN

Surveyed July 13, 1965, by *H. Jackson*